

JONES MISSISSIPPI BOARD OF WATER COMMISSIONERS

206 37
7-8-61


WATER WELL DRILLERS LOG

Cor 91

Date: 7/8, 1961, Driller: C. P. Clark County Jones

(Name)

		Description & Color of Materials Sand, Clay, Red Clay, Shell, etc.	Thick- ness Feet	Depth Feet
1) Owner of Land: <u>Archie Kimbrough</u> (Name)				
<u>Rt #6 Laurel Miss</u> (Address)		<u>0-15 Red Clay</u>	<u>15</u>	
		<u>15-20 - Fine Sand</u>	<u>05</u>	
		<u>20-58 Yellow Clay</u>	<u>38</u>	
2) Location: <u>1/4</u> , <u>1/4</u> , Sec. <u>11</u> T. <u>8 N</u> R. <u>11 W</u>		<u>58-75 fine yellow sand</u>	<u>17</u>	
<u>2</u> miles <u>East</u> of <u>Laurel</u>		<u>75-96 blue clay</u>	<u>21</u>	
(distance) (direction) (Nearest Town)		<u>96-110 Sand</u>	<u>14</u>	
3) Topography: <input checked="" type="checkbox"/> (Hilly) <input type="checkbox"/> (Flat) <input type="checkbox"/> (Level)		<u>110-160 blue clay</u>	<u>50</u>	
4) Purpose of Well: <u>Domestic</u> (Domestic Irrigation, Municipal, Industrial, Other)		<u>160-170 Sand</u>	<u>10</u>	
		<u>170-186 Clay Sand Strips</u>	<u>16</u>	
		<u>186-205 White Sand</u>	<u>19</u>	
		<u>205-230 Clay</u>	<u>25</u>	
Information upon completion of well:		<u>230-255 Sand Strips</u>	<u>25</u>	
1) Diameter <u>4</u> inches.		<u>255-325 Clay</u>	<u>70</u>	
2) Total Depth <u>365</u> feet.		<u>325-340 Medium Sand</u>	<u>15</u>	
3) Water Level <u>150</u> feet below top of ground.		<u>340-365 coarse Sand</u>	<u>25</u>	
4) Cased to <u>253</u> , Size <u>4 in</u>		<u>365-370 Clay</u>	<u>5</u>	
5) Screen: Size <u>3 3/4</u> , Length <u>12</u>				
6) Were any formations sealed against pollution? <u>Yes</u> , <u>no</u> .				
If YES depth of formation <u>240-253</u>				
Why <u>to seal red water from above</u>				
Drillers Remarks: <u>2 miles east on Hwy 84 on left at Kimbroughs Curb Market</u>				

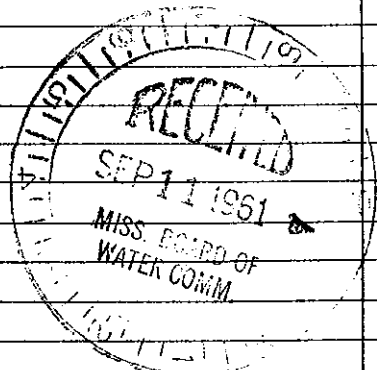

(Use Back Side)

Well No.

Mail this copy to Board of Water Commissioners 429 Miss. St. Jackson, Miss