

**JONES MISSISSIPPI BOARD OF WATER COMMISSIONERS**

G 38  
10-26-60

**WATER WELL DRILLERS LOG**  
C. P. CLARK

Date: 10/26, 1960, Driller: WATER WELL DRILLING County Jones  
ROUTE TWO  
LAUREL, MISS.

(1) Owner of Land:	Description & Color of Materials Sand, Clay, Red Clay, Shell, etc.	Thick- ness Feet	Depth Feet
<u>E. K. Collins</u> (Name) <u>Rt # 6 Laurel</u> (Address)	<u>0-11 Red Clay</u>	<u>11</u>	
(2) Location: <u>3</u> <u>8</u> <u>11</u> <u>2 1/2</u> miles <u>East</u> of <u>Laurel</u> (distance) (direction) (Nearest Town)	<u>11-51 Sand</u>	<u>40</u>	
(3) Topography: <input checked="" type="checkbox"/> (Hilly) <input type="checkbox"/> (Flat) <input type="checkbox"/> (Level)			
(4) Purpose of Well: <u>Domestic</u> (Domestic Irrigation Municipal, Industrial, Other)			


Information upon completion of well:

- (1) Diameter 2 inches.
- (2) Total Depth 51 feet.
- (3) Water Level 22 feet below top of ground.
- (4) Cased to 46, Size 2 in
- (5) Screen: Size 1 1/4, Length 5
- (6) Were any formations sealed against pollution?  
 yes,  no.

If YES depth of formation \_\_\_\_\_

Why \_\_\_\_\_

Drillers Remarks: 2 1/2 miles East on Hwy 84

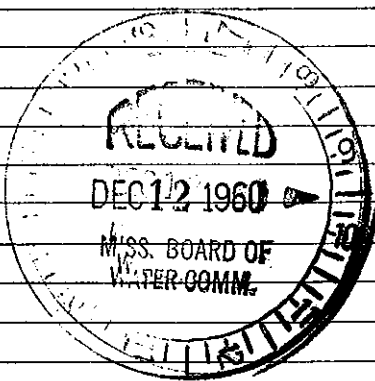

(Use Back Side)

Well No.