

JONES

MISSISSIPPI BOARD OF WATER COMMISSIONERS

G 40

WATER WELL DRILLERS LOG

3-6-62

Date: 3-6, 1962, Driller: H. J. Moseley County: Jones

(1) Owner of Land	Description & Color of Materials Sand, Clay, Red Clay, Shell, etc.	Thick- ness Feet	Depth Feet
Cooper Stewart (Name) Route #4 Laurel, Miss (Address) T8-N 13 R-W-	20' fine sand		
(2) Location: 1/4, 1/4, Sec. T R 6 miles East Laurel (distance) (direction) (Nearest Town)	then Chalk		
(3) Topography: (Hilly) (Flat) (Level)	to 168'		
(4) Purpose of Well: Home (Domestic Irrigation Municipal, Industrial, Other)	last 20' med.		
Course sand			

Information upon completion of well:

(1) Diameter: 2" inches.

(2) Total Depth: 198 feet.

(3) Water level: 65' feet below top of ground.

(4) Cased to: _____, Size: _____


(5) Screen: Size 1/4", Length 6'

(6) Were any formations sealed against pollution?
_____ yes, _____ no.

If YES depth of formation _____

Why _____

Drillers Remarks: _____

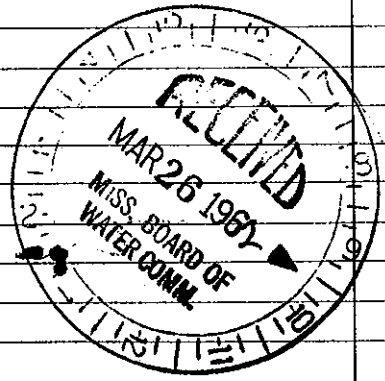

(Use Back Side)

Well No.

Mail this copy to Board of Water Commissioners 429 Miss. St. Jackson, Miss