

JONES

MISSISSIPPI BOARD OF WATER COMMISSIONERS

6 G 41

3-14-62

WATER WELL DRILLERS LOG

Date: 3/14, 1962, Driller: C.P. Clark County: Jones

(Name)

(1) Owner of Land:	Description & Color of Materials Sand, Clay, Red Clay, Shell, etc.	Thick- ness Feet	Depth Feet
Maxwell Jones (Name) Rt 4 Laurel Miss (Address)	0-15 Gray Clay	15	
(2) Location: 1/4, 1/4, Sec. 16, T. 11N, R. 11W	15-70 Blue Clay	75	
2 miles South Hwy 15 of Laurel (distance) (direction) (Nearest Town)	70-110 Sandy Clay	20	
(3) Topography: <input checked="" type="checkbox"/> (Hilly) <input type="checkbox"/> (Flat) <input type="checkbox"/> (Level)	110-165 Blue Clay	55	
(4) Purpose of Well: Domestic (Domestic Irrigation, Municipal, Industrial, Other)	165-200 Sandy Shales	35	
	200-260 Gray Sand	60	
	260-440 Blue Clay	180	
	440-485 Blue Sand	45	


Information upon completion of well:

- (1) Diameter 2 inches.
- (2) Total Depth 485' feet.
- (3) Water Level 120 feet below top of ground.
- (4) Cased to 467, Size 2
- (5) Screen: Size 1 1/4, Length 18
- (6) Were any formations sealed against pollution?
yes, no.

If YES depth of formation _____

Why _____

Drillers Remarks: _____

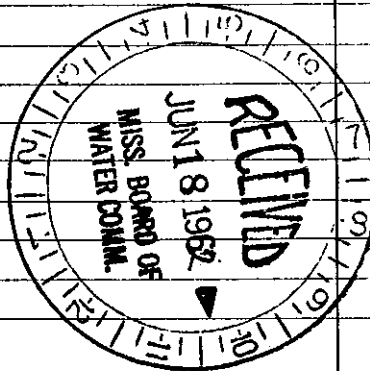

(Use Back Side)

Well No.

Mail this copy to Board of Water Commissioners 429 Miss. St. Jackson, Miss