

JONES

MISSISSIPPI BOARD OF WATER COMMISSIONERS

⑥ G42

3-20-62

WATER WELL DRILLERS LOG

Date: 3/20, 1962, Driller: G.P. Clark County Jones

(Name)

(1) Owner of Land:	Description & Color of Materials Sand, Clay, Red Clay, Shell, etc.	Thick- ness Feet	Depth Feet
P.A. Beard <small>(Name)</small> Rt #5 Laurel Miss <small>(Address)</small>	0-13 Sand	13	
(2) Location: 1/4, 1/4, Sec. 16, T. 11N, R. 11W 2 miles South of Laurel <small>(distance) (direction) (Nearest Town)</small>			
(3) Topography: <input checked="" type="checkbox"/> (Level) <small>(Hilly) (Flat) (Level)</small>			
(4) Purpose of Well: <input checked="" type="checkbox"/> Domestic Irrigation <small>(Municipal, Industrial, Other)</small>			


Information upon completion of well:

- (1) Diameter 2 inches.
- (2) Total Depth 13 feet.
- (3) Water level 4 feet below top of ground.
- (4) Cased to 8, Size 2
- (5) Screen: Size 1 1/4, Length 5
- (6) Were any formations sealed against pollution?  
 yes,  no.

If YES depth of formation \_\_\_\_\_

Why \_\_\_\_\_

Drillers Remarks: \_\_\_\_\_

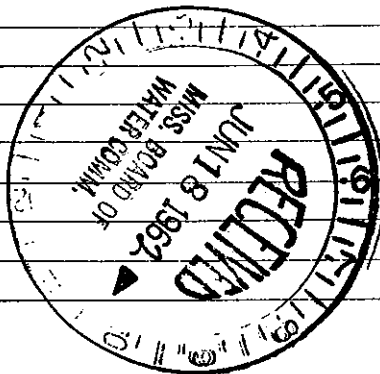

(Use Back Side)

Well No.

Mail this copy to Board of Water Commissioners 429 Miss. St. Jackson, Miss