

JONES

MISSISSIPPI BOARD OF WATER COMMISSIONERS

6 G 44

5-29-62

WATER WELL DRILLERS LOG

Date: 5/29, 1962, Driller: E.P. Clark County Jones

(Name)

(1) Owner of Land:	Description & Color of Materials Sand, Clay, Red Clay, Shell, etc.	Thick- ness Feet	Depth Feet
(Name) Laurence Moore	0-32 Red Clay	32	
(Address) Rt 4 Laurel Miss	32-90 Blue Clay	58	
(2) Location: 1/4, 1/4, Sec. 9 T. 8 N. R. 11 W.	90-110 Sandy Clay	20	
1 miles South of Laurel	110-180 Blue Clay	70	
(distance) (direction) (Nearest Town)	180-272 Gray Sand	92	
(3) Topography: <input checked="" type="checkbox"/> (Hilly) <input type="checkbox"/> (Flat) <input type="checkbox"/> (Level)	272-407 Blue Clay	135	
(4) Purpose of Well:	407-462 Blue Sand	55	
(Domestic Irrigation Municipal, Industrial, Other)			


Information upon completion of well:

- (1) Diameter 2 inches.
- (2) Total Depth 462 feet.
- (3) Water Level 132 feet below top of ground.
- (4) Cased to 452, Size 2
- (5) Screen: Size 1/4, Length 10
- (6) Were any formations sealed against pollution?  
yes,  no.

If YES depth of formation

Why

Drillers Remarks:

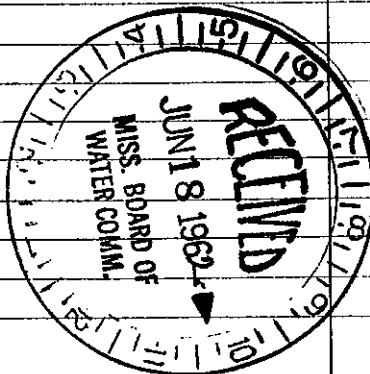

(Use Back Side)

Well No.

Mail this copy to Board of Water Commissioners 429 Miss. St. Jackson, Miss