

JONES

MISSISSIPPI BOARD OF WATER COMMISSIONERS

② G 4

6-29-62

WATER WELL DRILLERS LOG

Date: 6/29, 1962 Driller: C.P. Clark County Jones
(Name)

(1) Owner of Land:	Description & Color of Materials Sand, Clay, Red Clay, Shell, etc.	Thick- ness Feet	Depth Feet
Wayne Wilson (Name) Rt #1 Ellisville Miss (Address)	0-35 Grey Clay	35	
(2) Location: 1/4, 1/4, Sec. 34 T8N R11W	35-50 Sandy Clay	15	
6 miles South of Laurel (distance) (direction) (Nearest Town)	50-155 Blue Clay	105	
(3) Topography: <input checked="" type="checkbox"/> (Hilly) <input type="checkbox"/> (Flat) <input type="checkbox"/> (Level)	155-177 Sand	22	
(4) Purpose of Well: (Domestic, Irrigation, Municipal, Industrial, Other)			


Information upon completion of well:

- (1) Diameter 2 inches.
- (2) Total Depth 177 feet.
- (3) Water level 20 feet below top of ground.
- (4) Cased to 165, Size 2
- (5) Screen: Size 1 1/4, Length 12
- (6) Were any formations sealed against pollution?
yes, no.

If YES depth of formation

Why

Driller's Remarks: 6 miles South of Laurel on Hwy 15 South

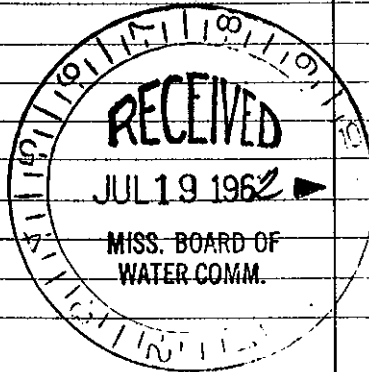

(Use Back Side)

Well No.

Mail this copy to Board of Water Commissioners 429 Miss. St. Jackson, Miss