

JONES MISSISSIPPI BOARD OF WATER COMMISSIONERS

G65 ③ VSGS file
7-24-64
WATER WELL DRILLERS LOG

Date: 7-24-, 1964, Driller: Layne-Central Co., County Jones

(Name)

(1) Owner of Land: Masonite Corp.

(Name)

Laurel, Mississippi

(Address)

(2) Location: NW 1/4, NW 1/4, Sec. 8 T8 R11W

_____ miles _____ of _____
(distance) (direction) (Nearest Town)

(3) Topography:

(Hilly) (Flat) (Level)

(4) Purpose of Well: industrial

(Domestic Irrigation
Municipal, Industrial, Other)

Description & Color of Materials Sand, Clay, Red Clay, Shell, etc.	Thick- ness Feet	Depth Feet
top soil	2	2
red clay-stks	58	60
hard clay	8	68
sandy clay	12	80
hard clay	28	108
sand	17	125
hard clay	19	144
sand-coarse	21	165
clay stks	2	167
sand	44	211

Information upon completion of well:

(1) Diameter 24 inches.

(2) Total Depth 209 feet.

(3) Water Level 137 feet below top of ground.

(4) Cased to 179', Size 16"

(5) Screen: Size 16", Length 30'


(6) Were any formations sealed against pollution?

X yes, _____ no.

If YES depth of formation 179'

Why _____

Drillers Remarks: _____

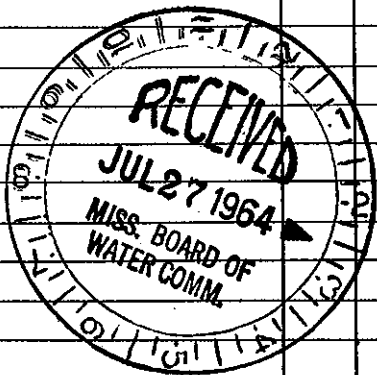

Well No.

(Use Back Side)

Mail this copy to Board of Water Commissioners 429 Miss. St. Jackson, Miss