


JONES MISSISSIPPI BOARD OF WATER COMMISSIONERS

E G 66 **(3)** *USGS file*
7-24-64
WATER WELL DRILLERS LOG

Date: 7-24-, 1964, Driller: Layne-Central Co. County Jones
(Name)

	Description & Color of Materials Sand, Clay, Red Clay, Shell, etc.	Thick- ness Feet	Depth Feet
(1) Owner of Land: <u>Masonite Corp.</u> <small>(Name)</small> <u>Laurel, Mississippi</u> <small>(Address)</small>	top soil	2	2
(2) Location: <u>NW 1/4, NW 1/4, Sec. 8 T8N R11W</u> _____ miles _____, of _____ <small>(distance) (direction) (Nearest Town)</small>	red clay-stks	58	60
(3) Topography: _____ <small>(Hilly) (Flat) (Level)</small>	hard clay	8	68
(4) Purpose of Well: <u>industrial</u> <small>(Domestic Irrigation Municipal, Industrial, Other)</small>	sandy clay	12	80
Information upon completion of well:	hard clay	28	108
(1) Diameter <u>16</u> inches.	sand	17	125
(2) Total Depth <u>413</u> feet.	hard clay	19	144
(3) Water Level <u>105'</u> feet below top of ground.	sand-coarse	21	165
(4) Cased to <u>358'</u> , Size <u>16"</u>	clay stks	2	167
(5) Screen: Size <u>10"</u> , Length <u>50'</u>	sand	44	211
(6) Were any formations sealed against pollution? <u>X</u> yes, _____ no.	clay	6	217
If YES depth of formation <u>358'</u>	sandy clay	27	244
Why _____ required	hard clay	74	318
Drillers Remarks: _____	sandy clay	37	355
_____	h.p. sand	58	413

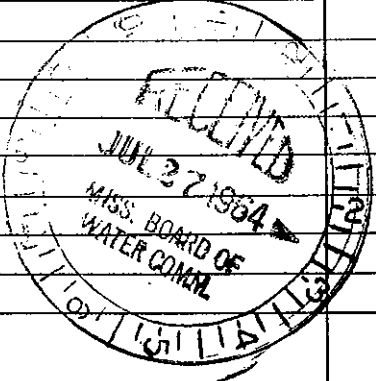

(Use Back Side)

Well No.

Mail this copy to Board of Water Commissioners 429 Miss. St. Jackson, Miss.