

JONES

MISSISSIPPI BOARD OF WATER COMMISSIONERS

669

WATER WELL DRILLERS LOG

10-31-62

Date: 10/31, 1962, Driller: R. J. Clark County Jones

(1) Owner of Land: <u>Gray Walters</u> (Name) <u>Laurel Miss</u> (Address)	Description & Color of Materials Sand, Clay, Red Clay, Shell, etc.	Thick- ness Feet	Depth Feet
	<u>0-39 Grey Clay</u>	<u>39</u>	
(2) Location: $\frac{1}{4}$, $\frac{1}{4}$, Sec. <u>27</u> ^{8^N} <u>T8^R</u> <u>3</u> miles <u>South</u> , of <u>Laurel</u> (distance) (direction) (Nearest Town)	<u>39-43 Fine Sand</u>	<u>4</u>	
	<u>43-160 Clay</u>	<u>117</u>	
(3) Topography: (Hilly) (Flat) (Level)	<u>160-200 Sandy Clay</u>	<u>20</u>	
	<u>200-220 Sand</u>	<u>20</u>	
(4) Purpose of Well: <u>Domestic</u> (Domestic Irrigation Municipal, Industrial, Other)			


Information upon completion of well:

- (1) Diameter 2 inches.
- (2) Total Depth 220 feet.
- (3) Water Level 15 feet below top of ground.
- (4) Cased to 210, Size 2 in.
- (5) Screen: Size 1/4, Length 10.
- (6) Were any formations sealed against pollution?
 yes, no.

If YES depth of formation _____

Why _____

Drillers Remarks: _____

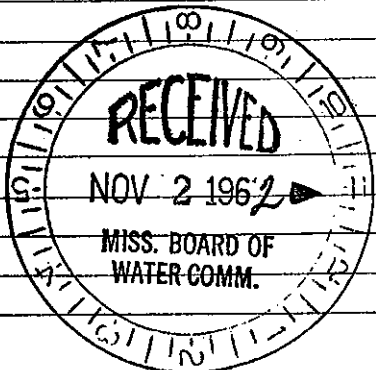

(Use Back Side)

Well No.

Mail this copy to Board of Water Commissioners 429 Miss. St. Jackson, Miss