

JONES

MISSISSIPPI BOARD OF WATER COMMISSIONERS

671


4-5-63

WATER WELL DRILLERS LOG

Date: 4/5, 1963, Driller: C.P. Clark County Jones

(Name)

	Description & Color of Materials Sand, Clay, Red Clay, Shell, etc.	Thick- ness Feet	Depth Feet
(1) Owner of Land: <u>F. Leggett</u> <u>Rt #1 Laurel Miss</u> (Name) (Address)	0-40 Clay	40	
(2) Location: <u>1/4, 1/4, Sec. 11</u> <u>2 miles East of Laurel</u> (distance) (direction) (Nearest Town)	40-60 Sandy Clay	20	
(3) Topography: <input checked="" type="checkbox"/> (Hilly) <input type="checkbox"/> (Flat) <input type="checkbox"/> (Level)	60-125 Grey Clay	65	
(4) Purpose of Well: <u>Domestic</u> (Domestic Irrigation Municipal, Industrial, Other)	125-152 Sandy Clay	27	
Information upon completion of well:	152-210 Course sand	59	
(1) Diameter <u>2</u> inches.	210-300 Blue Clay	90	
(2) Total Depth <u>340</u> feet.	300-340 Sand	40	
(3) Water Level <u>95</u> feet below top of ground.			
(4) Cased to <u>330</u> , Size <u>2 in</u>			
(5) Screen: Size <u>1/4</u> , Length <u>10</u>			
(6) Were any formations sealed against pollution? <u>no.</u>			
If YES depth of formation _____			
Why _____			
Drillers Remarks: _____			
_____			
_____			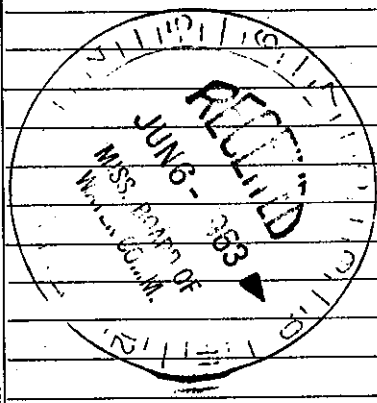
Well No.

(Use Back Side)

Mail this copy to Board of Water Commissioners 429 Miss. St. Jackson, Miss.