

JONES
DG 78

MISSISSIPPI BOARD OF WATER COMMISSIONERS

6-20-63

WATER WELL DRILLERS LOG

Date: 6/20, 1963, Driller: C.P. Clark County Jones


(Name)

(1) Owner of Land:	Description & Color of Materials Sand, Clay, Red Clay, Shell, etc.	Thick- ness Feet	Depth Feet
A. J. Cooper Rt #1 Laurel Miss (Address)	0-30 Sandy Clay	30	
	30-80 Clay	50	
(2) Location: 1/4, 1/4, Sec. 3 T8 R11 W4	80-135 Sandy Clay	55	
4 miles East of Laurel (distance) (direction) (Nearest Town)	135-205 Sand	70	
(3) Topography: <input checked="" type="checkbox"/> (Hilly) <input type="checkbox"/> (Flat) <input type="checkbox"/> (Level)	205-225 Clay	20	
(4) Purpose of Well: (Domestic Irrigation Municipal, Industrial, Other)	225-260 Sand	35	
	260-265 Clay	05	
	265-300 Sand	35	

Information upon completion of well:

- (1) Diameter 2 inches.
- (2) Total Depth 300 feet.
- (3) Water Level 105 feet below top of ground.
- (4) Cased to 290, Size 2.
- (5) Screen: Size 1 1/4, Length 10.
- (6) Were any formations sealed against pollution?
_____ yes, no.

If YES depth of formation _____
Why _____
Drillers Remarks: _____

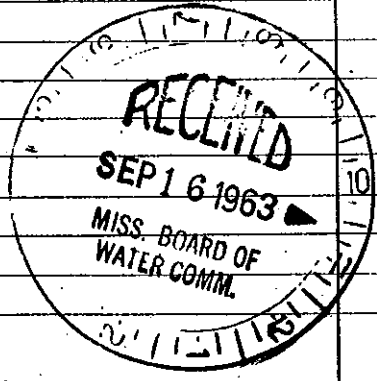

(Use Back Side)

Well No.

Mail this copy to Board of Water Commissioners 429 Miss. St. Jackson, Miss.