

JONES MISSISSIPPI BOARD OF WATER COMMISSIONERS

6 G 8
8-21-63

WATER WELL DRILLERS LOG

Date: 8/21, 1963, Driller: C. J. Clark County Jones
(Name)


(1) Owner of Land:	Description & Color of Materials	Thick-ness Feet	Depth Feet
<u>Otis Warren</u> (Name)	<u>0-60 Grey Chalk</u>	<u>60</u>	
<u>Rt #6 Laurel Miss</u> (Address)	<u>20-80 Sandy Clay</u>	<u>20</u>	
(2) Location: <u>1/4</u> , <u>1/4</u> , Sec. <u>3</u> <u>PN</u> <u>R 11W</u>	<u>80-170 Grey Clay</u>	<u>90</u>	
<u>1 1/2</u> miles <u>East</u> of <u>Laurel</u>	<u>170-190 Mixed Clay</u>	<u>20</u>	
(distance) (direction) (Nearest Town)	<u>190-211 Dry Sand</u>	<u>21</u>	
(3) Topography: <input checked="" type="checkbox"/> (Hilly) <input type="checkbox"/> (Flat) <input type="checkbox"/> (Level)	<u>211-280 Chalk</u>	<u>69</u>	
(4) Purpose of Well: <u>Domestic</u> (Domestic Irrigation, Municipal, Industrial, Other)	<u>280-320 Brown Clay</u>	<u>40</u>	
	<u>320-362 Sand</u>	<u>42</u>	

Information upon completion of well:

- (1) Diameter 2 inches.
- (2) Total Depth 362 feet.
- (3) Water Level 150 feet below top of ground.
- (4) Cased to 352 Size 2 in
- (5) Screen: Size 1/4, Length 10 ft.
- (6) Were any formations sealed against pollution?
 yes, no.

If YES depth of formation Seal 252
Why Seal Surface water

Drillers Remarks:

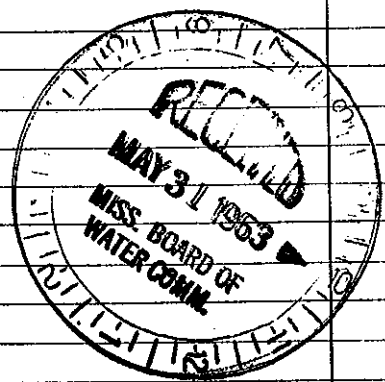

Well No.

(Use Back Side)

Mail this copy to Board of Water Commissioners 429 Miss. St. Jackson, Miss.