

JONES

MISSISSIPPI BOARD OF WATER COMMISSIONERS

WATER WELL DRILLERS LOG

⑥ G 86
6-27-63

Date: 6/27/63, 19___, Driller: C.P. Clark County Jones

(Name)

(1) Owner of Land: Hubert Walters
(Name)

Rt #1 Laurel Miss
(Address)

(2) Location: 1/4, 1/4, Sec. 27, T. 11 N., R. 11 W.

3 miles S.E. of Laurel
(distance) (direction) (Nearest Town)

(3) Topography: (Hilly) (Flat) (Level)

(4) Purpose of Well: Domestic Irrigation
 Municipal, Industrial, Other

Description & Color of Materials Sand, Clay, Red Clay, Shell, etc.	Thick- ness Feet	Depth Feet
0-50 Sandy Clay	50	
50-130 Clay	80	
130-215 Sand	85	
215-240 Clay	25	
240-280 Sand	40	
280-410 Clay	130	
410-445 Sand	35	

Information upon completion of well:

(1) Diameter 2 inches.

(2) Total Depth 445 feet.

(3) Water Level 85 feet below top of ground.

(4) Cased to 435, Size 2


(5) Screen: Size 1 1/4, Length 10

(6) Were any formations sealed against pollution?
no.

If YES depth of formation _____

Why _____

Drillers Remarks: _____

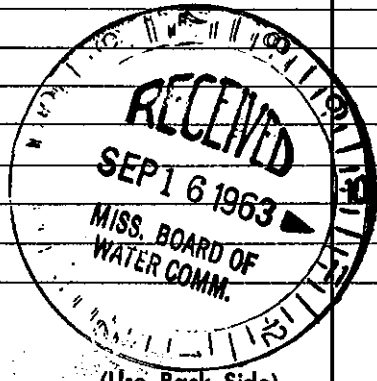

(Use Back Side)

Well No.

Mail this copy to Board of Water Commissioners 429 Miss. St. Jackson, Miss.