

JONES MISSISSIPPI BOARD OF WATER COMMISSIONERS

2) **G 91**

9-6-63

WATER WELL DRILLERS LOG

Date: 9/6, 1963, Driller: C. J. Clark County Jones

(Name)

(1) Owner of Land: F. H. Walker
(Name)
Samuel Miss
(Address)

(2) Location: 1/4, 1/4, Sec. 16 SW R11W
2 miles South of Samuel
(distance) (direction) (Nearest Town)

(3) Topography: Hilly (Flat) (Level)

(4) Purpose of Well: Domestic Irrigation
(Municipal, Industrial, Other)

Description & Color of Materials Sand, Clay, Red Clay, Shell, etc.	Thick- ness Feet	Depth Feet
0-20 Sandy Clay	20	
20-80 Grey Clay	40	
80-102 Coarse sand	22	
102-135 Clay	33	
135-210 Sandy Clay	75	
210-235 Clay	25	
235-257 Sand	22	
257-288 Clay	11	
288-315 Sand	27	
315-345 Clay	30	
345-400 Sand	55	
408-450 Sandy Clay	42	
450-485 Clay	35	
470-485 Sand Clay	15	
485-550 Sand	65	

Information upon completion of well:

(1) Diameter 4 inches.

(2) Total Depth 550 feet.

(3) Water Level 173 feet below top of ground.

(4) Cased to _____, Size _____


(5) Screen: Size _____, Length _____

(6) Were any formations sealed against pollution?
_____ yes, _____ no.

If YES depth of formation _____

Why _____

Drillers Remarks: _____

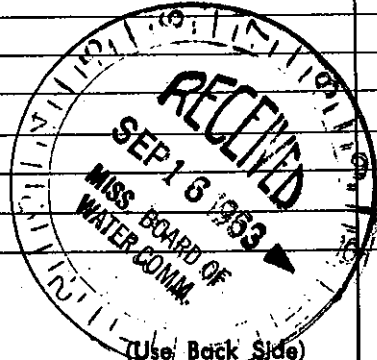

Well No. _____

Mail this copy to Board of Water Commissioners 429 Miss. St. Jackson, Miss.