

JONES MISSISSIPPI BOARD OF WATER COMMISSIONERS

3696

WATER WELL DRILLERS LOG

12-6-63

Date: Dec 6, 1963, Driller: Porter Drilling & Log Co. Jones
(Name)

(1) Owner of Land	Description & Color of Materials Sand, Clay, Red Clay, Shell, etc.	Thick- ness Feet	Depth Feet
<u>J. L. Orley</u> (Name)	<u>Clay</u>	<u>5</u>	<u>5</u>
<u>Rt 4 Laurel, Miss</u> (Address)	<u>fine sand</u>	<u>8</u>	<u>13</u>
(2) Location: <u>NW 1/4, SE 1/4, Sec. 15, T8 R11,</u>	<u>red shells</u>	<u>17</u>	<u>30</u>
<u>3 miles SE of Laurel</u> (distance) (direction) (Nearest Town)	<u>blue chalk</u>	<u>150</u>	<u>180</u>
(3) Topography: <u>hilly</u> (Hilly) (Flat) (Level)	<u>fine sand</u>	<u>10</u>	<u>190</u>
(4) Purpose of Well: <u>domestic</u> (Domestic Irrigation Municipal, Industrial, Other)	<u>most clean sand</u>	<u>24</u>	<u>214</u>
	<u>stapled white steel in sand</u>		


Information upon completion of well:

- (1) Diameter 2" inches. Copper
- (2) Total Depth 214' feet.
- (3) Water Level 63' feet below top of ground.
- (4) Cased to 199', Size 2"
- (5) Screen: Size 1 1/4", Length 10'
Johnson S.S.
- (6) Were any formations sealed against pollution?
_____ yes, _____ no.

If YES depth of formation _____

Why _____

Drillers Remarks: _____

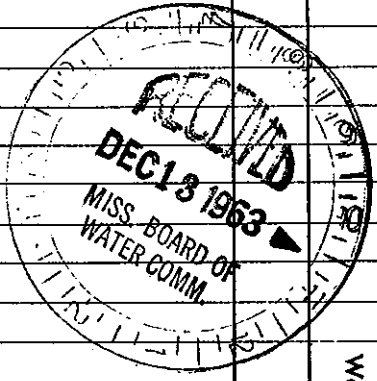

Well No. _____

(Use Back Side)

Mail this copy to Board of Water Commissioners 429 Miss. St. Jackson, Miss