

JONES MISSISSIPPI BOARD OF WATER COMMISSIONERS

5) **G98**
12-15-64

WATER WELL DRILLERS LOG

Date: 12/15, 1964, Driller: O.P. Clark County Jones
(Name)


(1) Owner of Land:	Description & Color of Materials Sand, Clay, Red Clay, Shell, etc.	Thick- ness Feet	Depth Feet
<u>Earline Guthrie</u> (Name)	<u>0-10 Red Sandy Clay</u>	<u>10</u>	
<u>Rt # 2 Laurel, Miss</u> (Address)	<u>10-110 Clay</u>	<u>100</u>	
(2) Location: <u>1/4</u> , <u>1/4</u> , Sec. <u>11</u> T <u>8</u> R <u>11</u> W	<u>110-115 fine Sand</u>	<u>05</u>	
<u>2 1/2</u> miles <u>East</u> of <u>Laurel</u> (distance) (direction) (Nearest Town)	<u>115-120 Clay</u>	<u>05</u>	
(3) Topography: <u>Hilly</u> (Hilly) (Flat) (Level)	<u>120-128 Sand</u>	<u>03</u>	
(4) Purpose of Well: <u>Domestic</u> (Domestic Irrigation Municipal, Industrial, Other)	<u>128-140 Clay</u>	<u>12</u>	
	<u>140-174 Clay</u>	<u>34</u>	
	<u>174-215 Key Sand</u>	<u>41</u>	
	<u>215-230 Clay</u>	<u>15</u>	
	<u>230-258 Sandy</u>	<u>28</u>	
	<u>258-278 Sand</u>	<u>20</u>	
	<u>278-338 Chalk</u>	<u>60</u>	
	<u>338-343</u>	<u>05</u>	
	<u>343-344 Clay</u>	<u>01</u>	
	<u>344-372 Sand</u>	<u>28</u>	

Information upon completion of well:

- (1) Diameter 2 inches.
- (2) Total Depth 372 feet.
- (3) Water Level 160 feet below top of ground.
- (4) Cased to 352, Size 2 in
- (5) Screen: Size 1 1/4, Length 20
- (6) Were any formations sealed against pollution?
 yes, no.

If YES depth of formation 325
Why Seal surface water

Drillers Remarks:

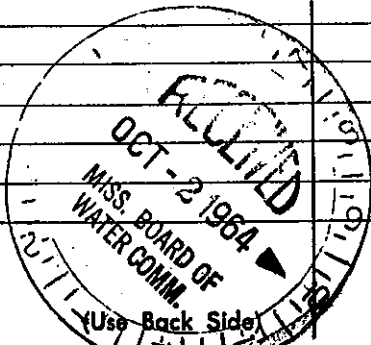

Well No.

Mail this copy to Board of Water Commissioners 429 Mississippi, Jackson, Miss.