


JONES MISSISSIPPI BOARD OF WATER COMMISSIONERS

① G 99
7-5-65

WATER WELL DRILLERS LOG

Date: 7/5, 1965, Driller: B.P. Clark County Jones
(Name)

(1) Owner of Land:	Description & Color of Materials Sand, Clay, Red Clay, Shell, etc.	Thick- ness Feet	Depth Feet
(Name) <u>Bible Baptist Church</u>	0-25 Sandy Clay	25	
#5 Pit: <u>Samuel Miss</u>	25-68 Sand	43	
(Address)			
(2) Location: <u>1/4</u> , <u>1/4</u> , Sec. <u>34</u> <u>SW</u> <u>R11W</u>			
<u>5</u> miles <u>South</u> of <u>Samuel</u>			
(distance) (direction) (Nearest Town)			
(3) Topography: <u>Hilly</u> (Flat) (Level)			
(4) Purpose of Well: <u>Domestic</u> , Irrigation, Municipal, Industrial, Other			
Information upon completion of well:			
(1) Diameter <u>2</u> inches.			
(2) Total Depth <u>68</u> feet.			
(3) Water Level <u>30</u> feet below top of ground.			
(4) Cased to <u>63</u> , Size <u>2 in</u>			
(5) Screen: Size <u>1 1/4</u> , Length <u>55.5</u>			
(6) Were any formations sealed against pollution?			
_____ yes, _____ no.			
If YES depth of formation _____			
Why _____			
Drillers Remarks: _____			

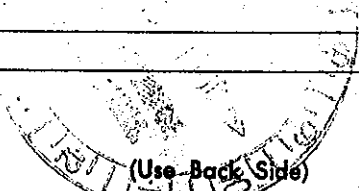

Well No.

Mail this copy to Board of Water Commissioners 429 Miss. St. Jackson, Miss