

JONES MISSISSIPPI BOARD OF WATER COMMISSIONERS

DG 100

11-13-65

WATER WELL DRILLERS LOG

Date: 11/13, 1965, Driller: C.P. Clark County, Jones

(Name)

(1) Owner of land: Chestnut Abbey
 Rt 5 Laurel Miss
 (Name)
 (Address)

(2) Location: 1/4, 1/4, Sec 16 T8N R11W
 2 miles South of Laurel
 (distance) (direction) (Nearest Town)

(3) Topography: (Hilly) (Flat) (Level)

(4) Purpose of Well: Domestic
 (Domestic Irrigation
 Municipal, Industrial, Other)

Description & Color of Materials Sand, Clay, Red Clay, Shell, etc.	Thick- ness Feet	Depth Feet
0-6 Clay	06	
6-15 Sand	9	
15-125 Clay	110	
125-152 Sand	27	
152-195 Clay	43	
195-262 Sand	67	
262-437 Clay	175	
437-475 Sand	38	

Information upon completion of well:

(1) Diameter: 7 inches.

(2) Total Depth: 475 feet.

(3) Water Level: 35 feet below top of ground.


(4) Cased to: 470, Size: 2 in

(5) Screen: Size: 1/4, Length: 5

(6) Were any formations sealed against pollution?
 yes, no.

If YES depth of formation:
 Why: 400 ft seal top water off

Drillers Remarks:

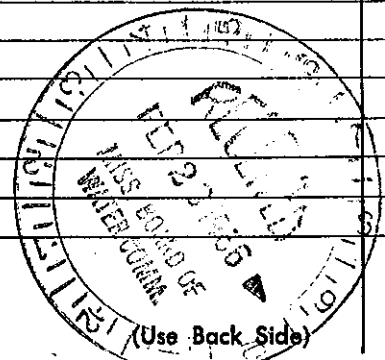

Well No.

Mail this copy to Board of Water Commissioners 429 Miss. St. Jackson, Miss.