

Jones
G101
10-67

MISSISSIPPI
BOARD OF WATER COMMISSIONERS
416 North State Street
Jackson, Mississippi 39201

WATER WELL DRILLERS LOG

10-17-19 67 Roy V. West Jones
date well completed firm name county well located

LANDOWNER: J McDonald
407 North pine
Laurel Miss
(mailing address)

description of formations encountered	from	to
Clay	0	10
Layered white	10	38
gray clay	38	145
sandy chalk	145	165
blue clay	165	178
sand	178	199

WELL LOCATION:
sec. 14 T. 8 N. R. 11 E
3 miles S.E. of Laurel
(distance) (direction) (nearest town)

WELL PURPOSE: Home
(home, irrigation, municipal, industrial)

WELL COMPLETION DATA:

(1) diameter (inches) 2 in

(2) total depth (feet) 199

(3) static water level (feet) 112 ^{below}/_{above} top of ground.

(4) casing Galv, 189
(material) (depth)

_____ if telescope see back.
(size)

(5) screen 10 ft, 189
(length) (depth to top)

1/4, Brass gauze
(size) (material)


(6) pump 1/2, 4
(HP) (yield gpm)

Rea
(type power)

(7) electric log no
(yes or no)

_____ (organization running log)

(8) how well bottom plugged washed

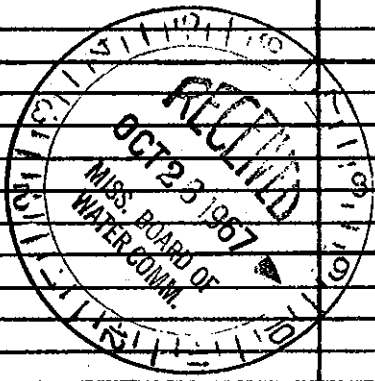

DRILLERS REMARKS: