

Jones
G 102
12/67

MISSISSIPPI
BOARD OF WATER COMMISSIONERS
416 North State Street
Jackson, Mississippi 39201

WATER WELL DRILLERS LOG


12.8 1967 Roy W. Westwater Jones
date well completed firm name county well located

LANDOWNER: <u>B.S. Brooks</u>	description of formations encountered	from	to
<u>Rt 6</u>			
<u>Laurel Miss</u> (mailing address)	<u>clay</u>	<u>0</u>	<u>20</u>
	<u>sand</u>	<u>20</u>	<u>40</u>

WELL LOCATION:
sec 33 T 8 N R 11 E
6 miles S of Laurel
(distance) (direction) (nearest town)

WELL PURPOSE: home
(home, irrigation, municipal, industrial)

- WELL COMPLETION DATA:
- (1) diameter (inches) 2 in
 - (2) total depth (feet) 40 ft
 - (3) static water level (feet) 16 below above top of ground.
 - (4) casing galv 35
(material) (depth)
(size) if telescope see back.
 - (5) screen 4 35
(length) (depth to top)
1/4 Stainless steel
(size) (material)
 - (6) pump 1/2 5
(HP) (yield gpm)
R.E.A.
(type power)
 - (7) electric log _____
(yes or no)
(organization running log)
 - (8) how well bottom plugged washed

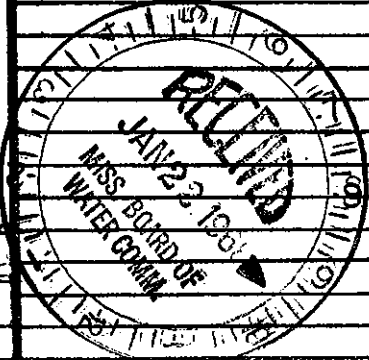

DRILLERS REMARKS: