

3




Jones
H 7
11-67

MISSISSIPPI
BOARD OF WATER COMMISSIONERS
416 North State Street
Jackson, Mississippi 39201

WATER WELL DRILLERS LOG

11.29 1967 Roy V. West Wilkly Jones
date well completed firm name county well located

LANDOWNER	description of formations encountered	from	to
Marvin Hinton RT 1			
Laurel Miss (mailing address)	Clay	0	25
	sandy clay	25	40
	sand	40	101
WELL LOCATION:			
sec 27 T 8 N R 10 E S W			
12 miles SE of Laurel (distance) (direction) (nearest town)			
WELL PURPOSE: Home use (home, irrigation, municipal, industrial)			
WELL COMPLETION DATA:			
(1) diameter (inches) 2			
(2) total depth (feet) 101			
(3) static water level (feet) 30 below above top of ground.			
(4) casing plastic 96 (material) (depth)			
(size) If telescope see back.			
(5) screen 5 96 (length) (depth to top)			
1 1/4 Stainless steel (size) (material)			
(6) pump 7 1/2 8 (HP) (yield gpm)			
RCA (type power)			
(7) electric log no (yes or no)			
(organization running log)			
(8) how well bottom plugged wash valve			
DRILLERS REMARKS:			

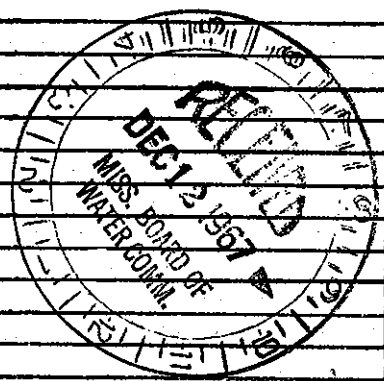

11-19-67