

JONES  
H9  
2-68

MISSISSIPPI  
BOARD OF WATER COMMISSIONERS  
416 North State Street  
Jackson, Mississippi 39201

WATER WELL DRILLERS LOG

2-26-68 1968 Roy V. West Jones  
date well completed firm name county well located


LANDOWNER: Wayne Touchette  
Rt 4  
Laurel Miss  
(mailing address)

| description of formations encountered | from | to  |
|---------------------------------------|------|-----|
| Clay                                  | 0    | 30  |
| Sandy clay                            | 30   | 55  |
| Sand                                  | 55   | 70  |
| Gray clay                             | 70   | 150 |
| Sandy clay                            | 150  | 185 |
| Blue clay                             | 185  | 210 |
| Sand                                  | 210  | 225 |

WELL LOCATION:  
sec. 21 T. 8 N. R. 10 E  
S W  
10 miles S.E. of Laurel  
(distance) (direction) (nearest town)

WELL PURPOSE: home  
(home, irrigation, municipal, industrial)

- WELL COMPLETION DATA:
- (1) diameter (inches) 2 in
  - (2) total depth (feet) 225
  - (3) static water level (feet) 80 below top of ground.
  - (4) casing galv 220 (material) (depth)
  - (size) if telescope see back.
  - (5) screen 5 ft 220 (length) (depth to top)
  - 1/2 Stainless steel (size) (material)
  - (6) pump 1 5 (HP) (yield gpm)
  - R.E.A. (type power)
  - (7) electric log No (yes or no)
  - (organization running log)
  - (8) how well bottom plugged wash valve

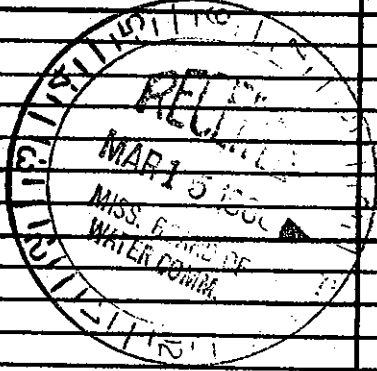

DRILLERS REMARKS: