

JONES  
H 2001  
1-1/76


MISSISSIPPI  
BOARD OF WATER COMMISSIONERS  
416 North State Street  
Jackson, Mississippi 39201

WATER WELL DRILLERS LOG

1-76  
date well completed

13¢ J. R. Green Water Drilling Jones  
firm name county well located

LANDOWNER:	description of formations encountered	from	to
Marrison Hedge	yellow chalk	0	10
Rt. 4 Laurel, Ms 39440 (mailing address)	White Sand	10	18
	" "	18	20
	" "	20	30
	" "	30	40
	" "	40	45
<b>WELL LOCATION:</b>			
sec 29 T. 8 S. R. 10 E. W. 3			
10 miles S.E. of Laurel (distance) (direction) (nearest town)			
<b>WELL PURPOSE:</b> (home, irrigation, municipal, industrial)			
<b>WELL COMPLETION DATA:</b>			
(1) diameter (inches) 4			
(2) total depth (feet) 45			
(3) static water level (feet) 15 below above top of ground.			
(4) casing P.V.C. 40 (material) (depth)			
(size) If telescope see back.			
(5) screen 5 40 (length) (depth to top)			
8" x .008 P.V.C. (size) (material)			
(6) pump 1/2 5 (HP) (yield gpm)			
110VAC (type power)			
(7) electric log NO (yes or no)			
(organization running log)			
(8) how well bottom plugged			
<b>DRILLERS REMARKS:</b>			

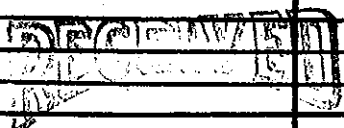

MAR 17 1976

MISS. BD. OF WATER COMM