

JONES

MISSISSIPPI BOARD OF WATER COMMISSIONERS

2301

J 10

WATER WELL DRILLERS LOG

11-9-60

Date: Nov 9, 1960, Driller: D. N. Porter & Son County Jones

	Description & Color of Materials Sand, Clay, Red Clay, Shell, etc.	Thick- ness Feet	Depth Feet
(1) Owner of Land: <u>State Forestry Comm.</u> (Name)		20	20'
<u>Jackson, Miss.</u> (Address)	<u>red clay</u>	74'	94'
(2) Location: <u>SW 1/4, NE 1/4, Sec. 25 T. 7 R. 13,</u>			
<u>4</u> miles <u>S.W.</u> of <u>Ellisville</u> (distance) (direction) (Nearest Town)			
(3) Topography: <u>hilly</u> (Hilly) (Flat) (Level)			
(4) Purpose of Well: <u>domestic</u> (Domestic Irrigation Municipal, Industrial, Other)			


Information upon completion of well:

- (1) Diameter 2" inches.
- (2) Total Depth 94' feet.
- (3) Water Level 70 feet below top of ground.
- (4) Cased to 84', Size 2"
- (5) Screen: Size 2", Length 10'
- (6) Were any formations sealed against pollution?
 yes, no.

If YES depth of formation _____

Why _____

Drillers Remarks: _____

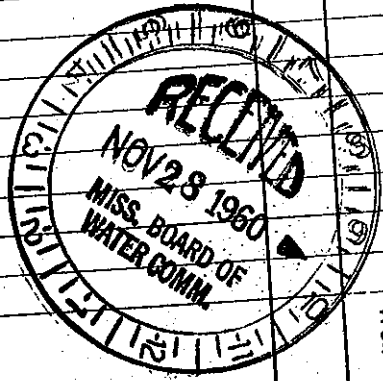

Well No.

(Use Back Side)

copy to Board of Water Commissioners 429 Miss. St. Jackson, Miss