

Jones  
 ③ J 13  
 8-67

MISSISSIPPI  
 BOARD OF WATER COMMISSIONERS ✓  
 416 North State Street  
 Jackson, Mississippi 39201

WATER WELL DRILLERS LOG

8-2-67 1967 Roy V. West Jones  
 date well completed firm name county well located


| LANDOWNER: L. R. Mass | description of formations encountered | from | to  |
|-----------------------|---------------------------------------|------|-----|
| Rt 2                  |                                       |      |     |
| Elisville Miss        | sandy clay                            | 0    | 10  |
| (mailing address)     | sand                                  | 10   | 84  |
|                       | gray clay                             | 84   | 120 |
|                       | green clay                            | 120  | 230 |
|                       | sand                                  | 230  | 294 |

WELL LOCATION:  
 NENE sec. 15 T. 7 N R. 13 E  
 4 miles S.W. of Elisville  
 (distance) (direction) (nearest town)

WELL PURPOSE: Chicken house  
 (home, irrigation, municipal, industrial)

WELL COMPLETION DATA:

- (1) diameter (Inches) 2 in
- (2) total depth (feet) 294
- (3) static water level (feet) 160 below top of ground.
- (4) casing galv 284 (material), (depth)
- (size) If telescope see back.
- (5) screen 10 ft 284 (length), (depth to top)  
 1/4" Stainless Steel (size), (material)
- (6) pump 1/2 (HP) 2 (yield gpm)  
 KEA (type power)
- (7) electric log no (yes or no)
- (organization running log)
- (8) how well bottom plugged Clay

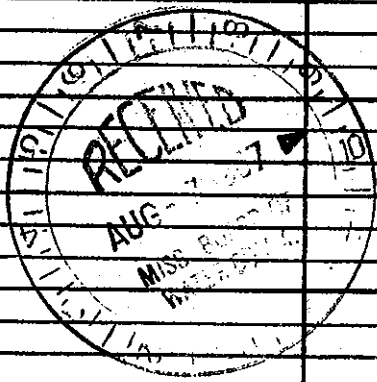

DRILLERS REMARKS: