

MISSISSIPPI BOARD OF WATER COMMISSIONERS

WATER WELL DRILLERS LOG

3-27-61

Date: 3-27, 1961, Driller: Hermon Baker Jones

(Name)

(1) Owner of Land:	Description & Color of Materials Sand, Clay, Red Clay, Shell, etc.	Thick- ness Feet	Depth Feet
Johny Thrash (Name)	Red CLAY	22	22
P. I. Seminary, Miss (Address)	Red CLAY	60	82
(2) Location: 1/4, 1/4, Sec. 34 T 7N R 13W	White SAND	50	132
(3) Topography: 1/6 miles EAST of Seminary (distance) (direction) (Nearest Town)			
(4) Purpose of Well: Hill (Domestic Irrigation, Municipal, Industrial, Other)			

Information upon completion of well:

(1) Diameter 2 inches.

(2) Total Depth 132 feet.

(3) Water Level 76 feet below top of ground.

(4) Cased to 132, Size 2"


(5) Screen: Size 2", Length 5'

(6) Were any formations sealed against pollution?  
yes, No no.

If YES depth of formation \_\_\_\_\_

Why \_\_\_\_\_

Drillers Remarks: \_\_\_\_\_

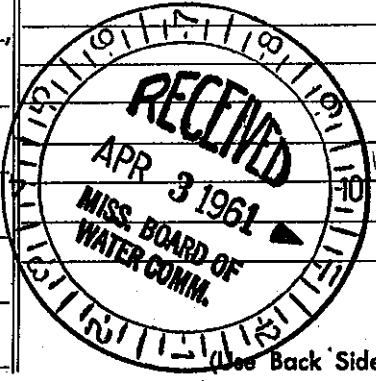

132  
19  
Well No.

Mail this copy to Board of Water Commissioners 429 Miss. St. Jackson, Miss