

Note: Test Hole

Mark As:
"Test Hole"
Number Two

MISSISSIPPI
BOARD OF WATER COMMISSIONERS
416 North State Street
Jackson, Mississippi 39201

WATER WELL DRILLERS LOG

CODE:

Jones

Jones
516
4-68
Schlumberger
April 68
date well completed

Robert E. Raloff
firm name
Co.

county well located


LANDOWNER: South
Miss. Electric
Power Ass'n. Mobile
(mailing address) Miss.

description of formations encountered	from	to
<u>top soil sand, cl. strks</u>	<u>0</u>	<u>22</u>
<u>sand, gravel strks</u>	<u>22</u>	<u>44</u>
<u>sand, clay strks</u>	<u>44</u>	<u>66</u>
<u>sand clay</u>	<u>66</u>	<u>88</u>
<u>sandy shale</u>	<u>88</u>	<u>153</u>
<u>white sand clay strks</u>	<u>153</u>	<u>219</u>
<u>white sand</u>	<u>219</u>	<u>274</u>
<u>sand, shale strks</u>	<u>274</u>	<u>284</u>
<u>shale, sand strks.</u>	<u>284</u>	<u>324</u>
<u>sand</u>	<u>324</u>	<u>338</u>
<u>shale, sand strks</u>	<u>338</u>	<u>349</u>
<u>sandy shale, sand</u>	<u>349</u>	<u>394</u>
<u>sand, shale</u>	<u>394</u>	<u>416</u>
<u>shale, sand strks</u>	<u>416</u>	<u>438</u>
<u>sand</u>	<u>438</u>	<u>456</u>
<u>shale, sand strks</u>	<u>456</u>	<u>460</u>
<u>sandy shale</u>	<u>460</u>	<u>616</u>

WELL LOCATION:
sec. — T — N — R — E
S — W
(distance) miles (direction) of (nearest town)

WELL PURPOSE: Industrial
(home, irrigation, municipal, industrial)

- WELL COMPLETION DATA:
- (1) diameter (inches) _____
 - (2) total depth (feet) _____
 - (3) static water level (feet) _____ below above top of ground.
 - (4) casing _____ (material) _____ (depth) _____
_____ If telescope see back.
(size) _____
 - (5) screen _____ (length) _____ (depth to top) _____
(size) _____ (material) _____
 - (6) pump _____ (HP) _____ (yield gpm) _____
(type power) _____
 - (7) electric log Yes (yes or no)
Schlumberger (organization running log)
 - (8) how well bottom plugged _____

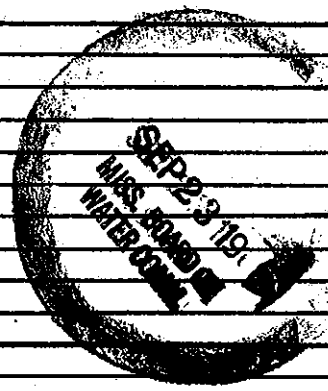

DRILLERS REMARKS: