

Note: Test Hole
mark as:

Jones
J17
4-68
USGS

MISSISSIPPI
BOARD OF WATER COMMISSIONERS "Test Hole
416 North State Street
Jackson, Mississippi 39201 Number Three"

WATER WELL DRILLERS LOG CODED

April 68 Robert E. Katloff Jones
date well completed firm name county well located

LANDOWNER: South Miss.
Electric Power Assn
Nashville, Miss
(mailing address)

| description of formations encountered | from | to |
|---------------------------------------|------|-----|
| Top soil, sand, gravel | 0 | 32 |
| clay | 32 | 69 |
| clay, sand streaks | 69 | 92 |
| sand, clay streaks | 92 | 125 |
| sand | 125 | 128 |
| sand, clay streaks | 128 | 200 |
| sand, gravel, clay streaks | 200 | 221 |
| sand, gravel | 221 | 243 |
| sand, small gravel | 243 | 262 |
| clay, sand | 262 | 265 |
| sand | 265 | 280 |
| clay, sand streaks | 280 | 287 |
| sand, clay streaks | 287 | 330 |
| sand | 330 | 352 |
| sandy shale | 352 | 417 |
| shale | 417 | 439 |
| shale, sand streaks | 439 | 449 |
| sand | 449 | 460 |
| shale | 460 | 470 |
| sand | 470 | 510 |
| sandy shale | 510 | 550 |

WELL LOCATION:
sec. _____ T _____ N _____ R _____ E _____
S _____ W _____
_____ miles _____ of _____
(distance) (direction) (nearest town)

WELL PURPOSE:
(home, irrigation, municipal, industrial)

WELL COMPLETION DATA:

(1) diameter (inches) _____

(2) total depth (feet) _____

(3) static water level (feet) _____ below above
top of ground.

(4) casing _____ (material) _____ (depth) _____
_____ (size) if telescope see back.


(5) screen _____ (length) _____ (depth to top) _____
_____ (size) _____ (material)

(6) pump _____ (HP) _____ (yield gpm) _____
(type power) _____

(7) electric log _____ (yes of no)
U.S.G.P. (organization running log)

(8) how well bottom plugged _____

State Board of
Health ran
chemical analysis
on water sample.
Test hole number
3 was made
into test well

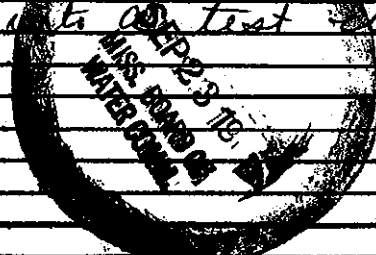

DRILLERS REMARKS: