

Jones
J24
11-5-68

MISSISSIPPI
BOARD OF WATER COMMISSIONERS
416 North State Street
Jackson, Mississippi 39201

CODED

WATER WELL DRILLERS LOG

11-5-68 1968 Roy West Jones
date well completed firm name county well located

LANDOWNER: RT 2 Ellisville Miss (mailing address)	description of formations encountered	depth	
		from	to
	clay	0	12
	sandy clay	12	26
	clay	26	100
	sand	100	156

WELL LOCATION:
sec. 12 T. 7 N. R. 13 E
3 miles S.W. of Ellisville
(distance) (direction) (nearest town)

WELL PURPOSE: Home
(home, irrigation, municipal, industrial)

WELL COMPLETION DATA:

(1) diameter (inches) 7

(2) total depth (feet) 156

(3) static water level (feet) 68 below top of ground.

(4) casing Galv 148 (material) (depth)

(size) If telescope see back.


(5) screen 8 148 (length) (depth to top)
1/4 St Steel (size) (material)

(6) pump 1/9 (HP) (yield gpm)
Rea (type power)

(7) electric log No (yes or no)

(organization running log)

(8) how well bottom plugged Wash water

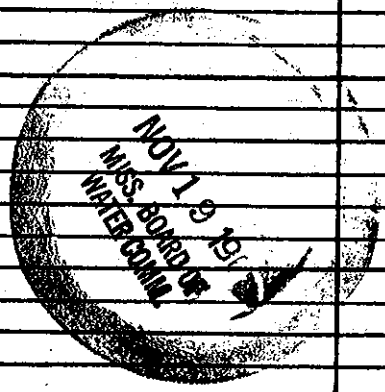

DRILLERS REMARKS: