

Jones  
J 25  
9-15-68

MISSISSIPPI  
BOARD OF WATER COMMISSIONERS  
416 North State Street  
Jackson, Mississippi 39201  
WATER WELL DRILLERS LOG

9-15 date well completed 1968 Henshell Taylor Water Well Drilling firm name Jones county well located


LANDOWNER: Harin Hennen  
Rt 2  
Edenville, Miss  
(mailing address)

description of formations encountered	from	to
chalk	0	30
chalk + sand	60	67
fine sand	67	72

WELL LOCATION:  
sec. 5 T. 7 N. R. 14 E  
2 3/4 miles W of Edenville  
(distance) (direction) (nearest town)

WELL PURPOSE: home  
(home, irrigation, municipal, industrial)

- WELL COMPLETION DATA:
- (1) diameter (inches) 2"
  - (2) total depth (feet) 72'
  - (3) static water level (feet) 50 below above top of ground.
  - (4) casing plac. 68  
(material) (depth)  
         if telescope see back.  
(size)
  - (5) screen 4' 68  
(length) (depth to top)  
2" 3/8  
(size) (material)
  - (6) pump 1 jet 600 gal/hr.  
(HP) (yield gpm)  
elect.  
(type power)
  - (7) electric log           
(yes or no)  
          
(organization running log)
  - (8) how well bottom plugged N/W

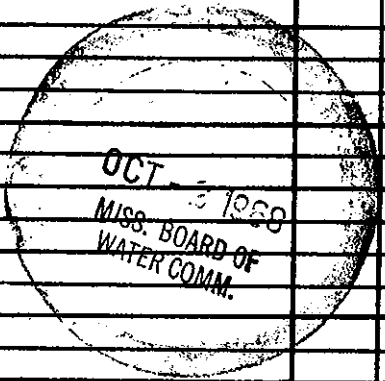

DRILLERS REMARKS: