
State W	ell Report	
	art 1	For Office Use Only:
	t of Environmental Quality	Aquifer:
Permit #: Office of Land a	nd Water Resources	Well #: J-114
	Box 10631	
	IS 39289-0631 961-5210	L. S. Elevation:
(601)35	4-6938 (fax)	E-log #:
	1. W in detail and filed w	with the Department within
State Law requires that this report be prepared by the 30 days of completion of drilling of the well.	driller in detail and med w	in the Department within
Well Owner Information	Wel	l Location
Owner Name Al Watkins	Latitude: ° '	_" Longitude:°"
Mailing Address: 3168 Monroe R	Method of Lat/Long (circle or	
	USGS quad, Hand-held	I GPS, Survey-grade GPS
211: suille MS 39437	1/4 Sec_2 4	<u>Twn 7N Rng 14N</u>
City State Zip Code	Distance Direction Miles	Nearest Town
Telephone No. (60) 762 2773	$-\underline{C} Miles \underline{N} U$	of <u>MOSELLY</u>
Weil	Data	
Purpose of Well (circle one) Home Industrial Public Supply	Irrigation Fish Culture	Other Chicken Huse Schall
Date well drilling started: $4/5/04$ Date		
If flowing, method of flow regulation: Valve Other (or	,	· · · · · · · · · · · · · · · · · · ·
Static Water Level: <u>149</u> feet above or below (circle one)		
Method of Measurement (circle one) steel tape electric tape		
Hole depth: $340'$ Well depth: $335'$		
Type of grout (circle one): Cement Bentonite		
Casing length: <u>315</u> feet Casing diameter: <u>4</u>	inches Type of casing:	
Screen length: feet Screen diameter:	inches Type of screen:	PVC slot
Screen slot size: $\underline{0, p/0}$ inches Setting depth: From _	<u>315</u> feet to <u>3</u>	<u>35</u> feet
Type of completion (circle all applicable): Gravel packed Under	reamed Telescoped Oper	hole Natural Development
Other (describe):		
Top of lap pipe or reduction in casing:feet. If te	lescoped or more than one sci	reen, describe on back of page
Logs run (circle all applicable): No log run Electric Gamma Ray	Density Sonic Neutron	Other:
Name of organization running log(s):		
I certify that the well was drilled, constructed, and completed in		
Department of Environmental Quality and/or the Mississippi De	partment of Health regulation	is and state laws.
J.P. THOMPSON 0-6	24 1.1	Hampson
Print Name of Water Well Contractor and License No.	Signature of	f Water Well Contractor
		RECEIVED
		JUN 2 9 2006
	•	BY: OLWR

۴

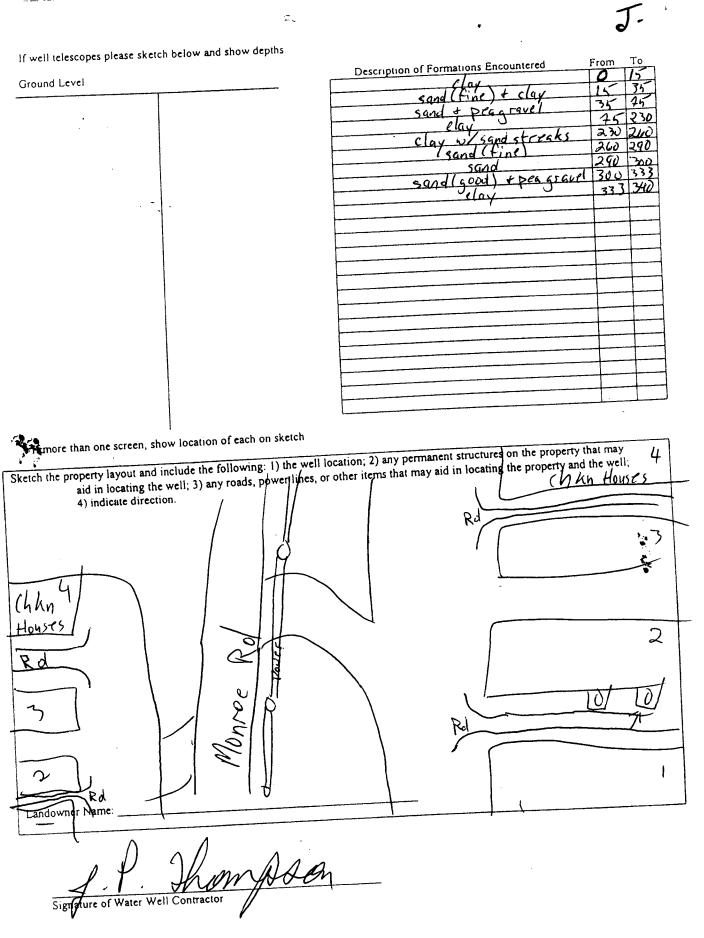

Shinger.

	**		
County: <u>Jones</u> Permit #:	Pump Installe Mississippi Departm	ELL REPORT Part 2 r's Completion Report tent of Environmental Quality	For Office Use Only: Aquifer:
Driller: Date completed: U / U / D U	Office of Land and Water Resources P.O. Box 10631 Jackson, MS 39289-0631 (601)961-5210 (601)354-6938 (fax)		Well #: <u>J-114</u> Elevation:
This report should be prepared by th installation of pump.	be pump installer in de	tail and filed with the Departme	ent within 30 days of the
Well Owner Information Owner Name: <u>AUG4Ki</u> Mailing Address: <u>SI 108 MOU</u> <u>Elissiller</u> City State Telephone No. (CO) 75221	nroeRd Ms 39437 Zip Code	Latitude: Method of Lat/Long (circle on USGS quad, Hand	-held GPS, Survey-grade GPS <u>Twn</u> <u>M</u> Rng <u>14</u> Nearest Town
Centrifugal Rotary Other (specify): Date Pump Installed:/15/04	Submersible Turbine Flowing Well	Pow Cir Diesel Engine Gasoline Electric Motor Hand	ver Type rcle one e Engine Natural Gas Tractor PTO specify):
i crt	elow Land Surface	Method of Meas Circ	suring Water Level cle one pring Line Steel Tape
Pumping Water Level (B): <u>170</u> Feet Be Drawdown [(B) – (A)]: <u>3</u> Feet Be est Pumping Rate: <u>50</u> G: Puration of Pump Test (minimum 4 hours):	allons Per Minute	For flowing well, measured shut Well yielded	in head:feet
HEREBY CERTIFY that the above statement TPTTHOMPS int Name of Pump Installer and License No.	ON 0-624	my knowledge.	Lompson

٢

(1)

ł

ŧ

JUN 2 9 2006 BY: OLWR **,** :

ŧ :