

Permit #: SP-10-250  
Driller: J.R. Parker  
Date drilling completed: \_\_\_\_\_

**CART 1**  
Mississippi Department of Environmental Quality  
Office of Land and Water Resources  
P.O. Box 10631  
Jackson, MS 39289-0631  
(601)961-5210  
(601)354-6938 (fax)

Aquifer: \_\_\_\_\_  
Well #: J-119  
L. S. Elevation: \_\_\_\_\_  
E-log #: \_\_\_\_\_

State Law requires that this report be prepared by the driller in detail and filed with the Department within 30 days of completion of drilling of the well.

Well Owner Information	Well Location
Owner Name: <u>TONY DAVIS</u>	Latitude: <u>31°31'24"</u> Longitude: <u>89°20'28"</u>
Mailing Address: <u>130 WATKINS RD</u>	Method of Lat/Long (circle one): Conventional Survey, USGS quad, Hand-held GPS, Survey-grade GPS
<u>MOSELLE MS 39459</u> City State Zip Code	<u>31</u> <u>7</u> <u>13W</u> 1/4 Sec 1/4 Sec Twn Rng
Telephone No. <u>(601) 752-2430</u>	Distance <u>5</u> Miles Direction <u>WEST</u> of Nearest Town <u>MOSELLE</u>

**Well Data**

Purpose of Well (circle one) Home Industrial Public Supply Irrigation Fish Culture Other: \_\_\_\_\_

Date well drilling started: 12-4-06 Date well drilling completed: Plugged 12-8-12

If flowing, method of flow regulation: Valve \_\_\_\_\_ Other (describe) \_\_\_\_\_

Static Water Level: NONE feet above or below (circle one) land surface Date measured: 12-7-12

Method of Measurement (circle one) steel tape electric tape air line other: NO WATER

Hole depth: 215 Well depth: 200 Well grouted to a depth of \_\_\_\_\_ feet

Type of grout (circle one): Cement Bentonite Mix

Casing length: 180 feet Casing diameter: 4 inches Type of casing: PVC

Screen length: 20 feet Screen diameter: 4" inches Type of screen: PVC

Screen slot size: 008 inches Setting depth: From 180 feet to 200 feet

Type of completion (circle all applicable): Gravel packed Underreamed Telescoped Open hole Natural Development  
Other (describe): CEMENTED TOP TO BOTTOM

Top of lap pipe or reduction in casing: \_\_\_\_\_ feet. If telescoped or more than one screen, describe on back of page

Logs run (circle all applicable): No log run Electric Gamma Ray Density Sonic Neutron Other: \_\_\_\_\_

Name of organization running log(s): \_\_\_\_\_

I certify that the well was drilled, constructed, and completed in accordance with all applicable requirements of the Mississippi Department of Environmental Quality and/or the Mississippi Department of Health regulations and state laws.


JOHN R. PARKER J.R. Parker  
Print Name of Water Well Contractor and License No. Signature of Water Well Contractor

RECEIVED  
FEB 14 2007  
BY: J. D. W. R.

Ground Level

Description of Formations Encountered

From To

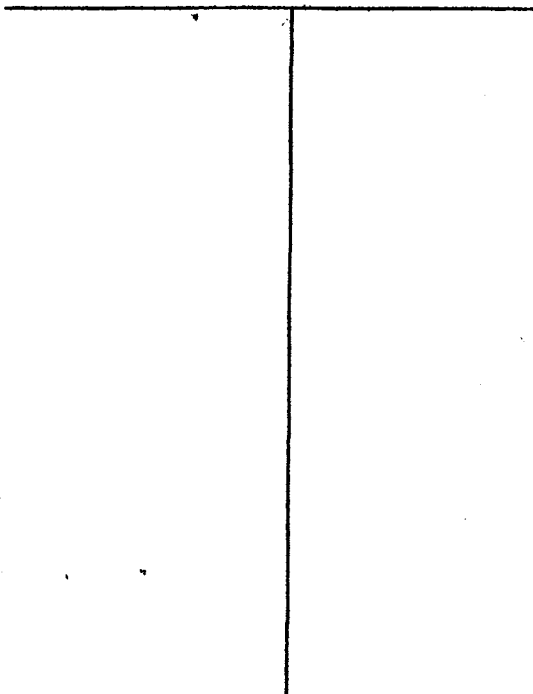


Description of Formations Encountered	From	To
SAND	0	120
CLAY	120	180
SAND	180	200
CLAY	200	212

J-119

If more than one screen, show location of each on sketch

Sketch the property layout and include the following: 1) the well location; 2) any permanent structures on the property that may aid in locating the well; 3) any roads, power lines, or other items that may aid in locating the property and the well; 4) indicate direction.

# 1  
⊗

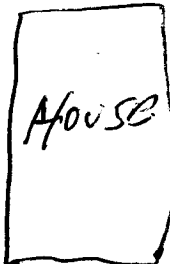

Landowner Name: \_\_\_\_\_

John R Park  
Signature of Water Well Contractor

Drill Date  
Drill Log  
Drill Log