


JONES MISSISSIPPI BOARD OF WATER COMMISSIONERS

3K 1/2 K11
7-29-65
WATER WELL DRILLERS LOG

Date: July 29, 1965, Driller: Layne-Central Co. County: Jones

(Name)

(1) Owner of Land: <u>City of Ellisville</u> <small>(Name)</small>	Description & Color of Materials Sand, Clay, Red Clay, Shell, etc.	Thick- ness Feet	Depth Feet
<u>Ellisville, Mississippi</u> <small>(Address)</small>	top soil	1	1
(2) Location: <u>NE 1/4, SE 1/4, Sec. 4 T7N R12E</u> _____ miles _____, of _____ <small>(distance) (direction) (Nearest Town)</small>	clay	11	12
(3) Topography: _____ <small>(Hilly) (Flat) (Level)</small>	sand	3	15
(4) Purpose of Well: <u>Municipal</u> <small>(Domestic Irrigation Municipal, Industrial, Other)</small>	clay	7	22
Information upon completion of well:	sand rock	5	27
(1) Diameter <u>12</u> inches.	clay	60	87
(2) Total Depth <u>562</u> feet.	blue clay-stks sand	136	223
(3) Water Level <u>63</u> feet below top of ground.	hard clay	23	246
(4) Cased to <u>501'</u> , Size <u>12"</u>	stks clay-sand-white	80	326
(5) Screen: Size <u>8"</u> , Length <u>50'</u>	clay-stks sand	31	357
(6) Were any formations sealed against pollution? <u>X</u> yes, _____ no.	rock	1	493
If YES depth of formation <u>501'</u>	clay-stks fine sand	135	493
Why _____ required	sand	69	562
Drillers Remarks: _____	clay	1	563

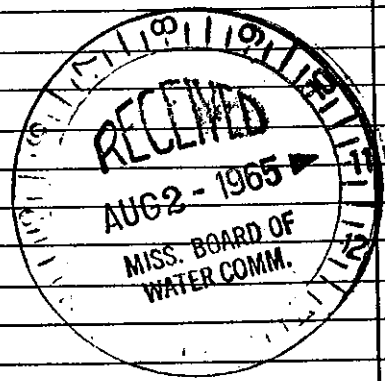

(Use Back Side)

Well No.

Mail this copy to Board of Water Commissioners 429 Miss. St. Jackson, Miss.