

COMMISSIONERS

WATER WELL DRILLERS LOG ✓

JONES  
 ⑥ K 14  
 10-68

Date: Oct 9, 1967, Driller: Leamon Thread County Jones  
 (Name)

(1) Owner of Land:	Description & Color of Materials Sand, Clay, Red Clay, Shell, etc.	Thick- ness Feet	Depth Feet
<u>Paul Price</u> (Name)	<u>Chalk</u>	<u>25</u>	<u>215</u>
(Address)	<u>Shell</u>	<u>40</u>	<u>40</u>
(2) Location: <u>26</u> <u>7</u> <u>12</u> <u>S E</u> <u>T R 12</u> <u>8</u>	<u>Sand</u>	<u>60</u>	<u>60</u>
<u>4</u> miles <u>SE</u> of <u>Ellenville</u> (distance) (direction) (Nearest Town)		<u>375</u>	<u>375</u>
(3) Topography: _____ (Hilly) (Flat) (Level)			
(4) Purpose of Well: <u>Domestic</u> (Domestic Irrigation Municipal, Industrial, Other)			

Information upon completion of well:


- (1) Diameter 2" inches.
- (2) Total Depth 375 feet.
- (3) Water Level 38 feet below top of ground.
- (4) Cased to \_\_\_\_\_, Size 2"
- (5) Screen: Size 2", Length 5'
- (6) Were any formations sealed against pollution?  
 yes,  no.

If YES depth of formation \_\_\_\_\_

Why \_\_\_\_\_

Drillers Remarks: \_\_\_\_\_

MAY 13 1968  
 MISS. BD. OF  
 WATER COM. ✓

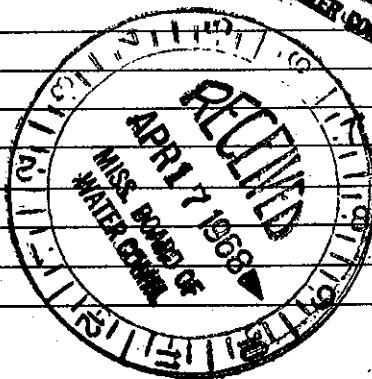

(Use Back Side)

Well No.

Mail this copy to Board of Water Commissioners 429 Miss. St. Jackson, Miss