

JONES

MISSISSIPPI BOARD OF WATER COMMISSIONERS

WATER WELL DRILLERS LOG

2-6-62

Date: Feb. 6, 1962, Driller: W. J. Tracey County Jones

	Description & Color of Materials Sand, Clay, Red Clay, Shell, etc.	Thick- ness Feet	Depth Feet.
(1) Owner of Land: Jesse Newell (Name) Route #3 Collierville, Miss. (Address)			
(2) Location: S 1/4, W 1/4, Sec. 30 T11R122W 5 miles South Collierville (distance) (direction) (Nearest Town)			
(3) Topography: (Level)			
(4) Purpose of Well: Home use (Domestic Irrigation, Municipal, Industrial, Other)			

Chalk to 20'
Fine sand from
there to 100'

Information upon completion of well:

(1) Diameter 2" inches.

(2) Total Depth 95 feet.

(3) Water Level 48 feet below top of ground.

(4) Cased to 16', Size 2" 1/4"


(5) Screen: Size 1 1/4", Length 6'

(6) Were any formations sealed against pollution?
_____ yes, _____ no.

If YES depth of formation _____

Why _____

Drillers Remarks: _____

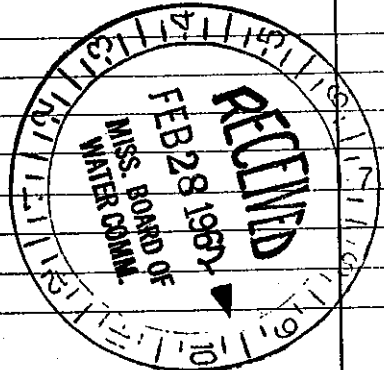

(Use Back Side)

Well No.

Mail this copy to Board of Water Commissioners 429 Miss. St. Jackson, Miss.