

JONES

⑥ K18

11-5-63

### WATER WELL DRILLERS LOG

Date 11-5, 1963, Driller: H.J. Mayey County Jones

(Name)

(1) Owner of Land: C. A. Mahon  
(Name)

Rt #1 Ellisville, Miss  
(Address)

(2) Location: 5 1/4, 2k 1/4, 30 T. R.  
5 miles South, of Ellisville  
(distance) (direction) (Nearest Town)

(3) Topography:  (Hilly)  (Flat)  (Level)

(4) Purpose of Well: None  
(Domestic Irrigation, Municipal, Industrial, Other)

Description & Color of Materials Sand, Clay, Red Clay, Shell, etc.	Thick- ness Feet	Depth Feet
Clay Chert		
Down to 70'		
Sand from		
here to		
313' hard		
Chert to		
340' 10'		
fine sand		
to 353'		

#### Information upon completion of well:

(1) Diameter: 2" inches.

(2) Total Depth: 353 feet.

(3) Water level: 80 feet below top of ground.

(4) Cased to \_\_\_\_\_, Size \_\_\_\_\_


(5) Screen: Size 1 1/4, Length 6'

(6) Were any formations sealed against pollution?  
\_\_\_\_\_ yes,  no.

If YES depth of formation \_\_\_\_\_

Why \_\_\_\_\_

Drillers Remarks: \_\_\_\_\_

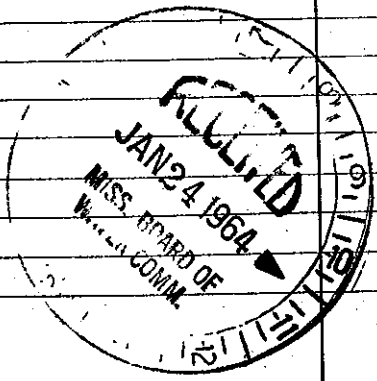

(Use Back Side)

Well No.

Mail this copy to Board of Water Commissioners 429 Miss. St. Jackson, Miss