

C. P. CLARK
WATER WELL DRILLING
 ROUTE 2

MISSISSIPPI LAUREL, MISS. 39440
 BOARD OF WATER COMMISSIONERS
 416 North State Street
 Jackson, Mississippi 39201

WATER WELL DRILLERS LOG

JONES
 K 23
 3-68

3/21 1968 C.P. Clark Jones
 date well completed firm name county well located


LANDOWNER: M.D. Holston
 Laurel, Miss
 (mailing address)

description of formations encountered	from to	
0-15 Sandy Clay	0-	15
Hard Musc. Clay	15	70
fine sand	70	96

WELL LOCATION:
 sec. 13 T-7 N R-12 E
 4 miles S.E. of Ellersville
 (distance) (direction) (nearest town)

WELL PURPOSE: Home
 (home, irrigation, municipal, industrial)

- WELL COMPLETION DATA:
- (1) diameter (inches) 2
 - (2) total depth (feet) 96
 - (3) static water level (feet) 65 below above top of ground.
 - (4) casing Galv. 80
 (material) (depth)
1 1/4 If telescope see back.
 (size)
 - (5) screen 16 Brass 50
 (length) (depth to top)
1 1/4 Brass
 (size) (material)
 - (6) pump 1 8
 (HP) (yield gpm)
220V Single Phase
 (type power)
 - (7) electric log NO
 (yes or no)
 (organization running log)
 - (8) how well bottom plugged B.W.U.

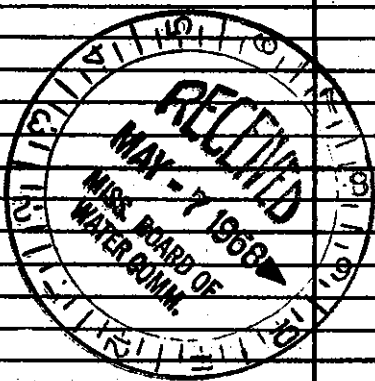

DRILLERS REMARKS: