

Jones  
R 24  
10-24-68

MISSISSIPPI  
BOARD OF WATER COMMISSIONERS  
416 North State Street  
Jackson, Mississippi 39201

CODED

WATER WELL DRILLERS LOG

10.24 1968 Ray West Jones  
date well completed firm name county well located


LANDOWNER: Sam Knight  
Rt 2  
Ellisville Miss  
(mailing address)

description of formations encountered	from	to
<u>gray clay</u>	<u>0</u>	<u>20</u>
<u>sandy clay</u>	<u>20</u>	<u>40</u>
<u>sand</u>	<u>40</u>	<u>99</u>

WELL LOCATION:  
sec 5 T 7 N R 12 E  
2 miles W of Ellisville  
(distance) (direction) (nearest town)

WELL PURPOSE: home  
(home, irrigation, municipal, industrial)

- WELL COMPLETION DATA:
- (1) diameter (inches) 2
  - (2) total depth (feet) 99
  - (3) static water level (feet) 28 ~~below~~ above top of ground.
  - (4) casing galv 94  
(material) (depth)  
\_\_\_\_\_ if telescope see back.  
(size)
  - (5) screen 6 93  
(length) (depth to top)  
1/4 st steel  
(size) (material)
  - (6) pump 1/2 5  
(HP) (yield gpm)  
Rea  
(type power)
  - (7) electric log no  
(yes or no)
  - (8) how well bottom plugged Washed  
(organization running log)

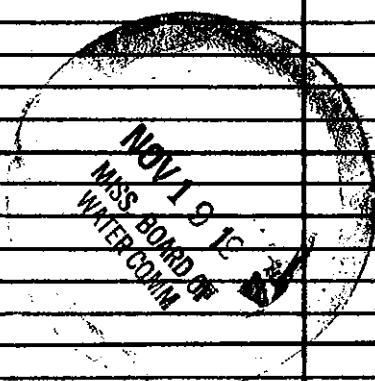

DRILLERS REMARKS: