

JONES


MISSISSIPPI BOARD OF WATER COMMISSIONERS

DL 17 L2
6-4-63

WATER WELL DRILLERS LOG

Date: 6/4, 1963, Driller: C.C. Clark County Jones
(Name)

(1) Owner of Land:	Description & Color of Materials Sand, Clay, Red Clay, Shell, etc.	Thick- ness Feet	Depth Feet
Hubert Smith (Name)	0-15 red clay	15	
Rt #1 outlet miss (Address)	15-82 red sand	63	
(2) Location: NW 1/4, NE 1/4, Sec. 1, 3 rd R/1/4	82-420 Blue clay	357	
9 miles S.E. of Laurel (distance) (direction) (Nearest Town)	420-455 Blue sand		
(3) Topography: <input checked="" type="checkbox"/> (Hilly) <input type="checkbox"/> (Flat) <input type="checkbox"/> (Level)			
(4) Purpose of Well: Domestic (Domestic Irrigation, Municipal, Industrial, Other)			
Information upon completion of well:			
(1) Diameter 2 inches.			
(2) Total Depth 455 feet.			
(3) Water Level 85 feet below top of ground.			
(4) Cased to 440, Size 2 in.			
(5) Screen: Size 1/4, Length 15.			
(6) Were any formations sealed against pollution? <input checked="" type="checkbox"/> yes, <input type="checkbox"/> no.			
If YES depth of formation 420			
Why			
Drillers Remarks:			

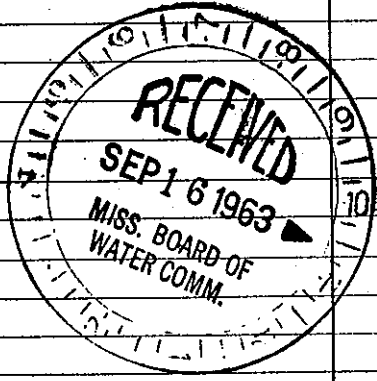

(Use Back Side)

Well No.

Mail this copy to Board of Water Commissioners 429 Miss. St. Jackson, Miss