

JONES

MISSISSIPPI BOARD OF WATER COMMISSIONERS

H/L 14

WATER WELL DRILLERS LOG

4-9-63

Date: 4/9, 1963, Driller: C.O. Clark County Jones

(Name)

(1) Owner of Land: Lawson Jewelry

Rt #1 Laurel

(Address)

(2) Location: 1/4, 1/4, Sec. 2, T. 7N, R. 11W

8 miles S.E. of Laurel

(distance) (direction) (Nearest Town)

(3) Topography: (Hilly) (Flat) (Level)

(4) Purpose of Well: Washeteria

(Domestic Irrigation, Municipal, Industrial, Other)

Description & Color of Materials Sand, Clay, Red Clay, Shell, etc.

Thick-ness Feet

Depth Feet

0-8 Red Clay	8	
8-28 Yellow Sand	20	
28-98 White Sand	70	
98-150 Sandy Clay	52	
150-157 Grey Clay	07	
157-237 Sand	80	
237-310 Sandy Clay	73	
310-362 Sand	52	

Information upon completion of well:

(1) Diameter 4 inches.

(2) Total Depth 362 feet.

(3) Water Level 65 feet below top of ground.

(4) Cased to 351, Size 4 in

(5) Screen: Size 3 3/4, Length 11


(6) Were any formations sealed against pollution?

yes, no.

If YES depth of formation 275

Why Cut of Red Water

Drillers Remarks: from above

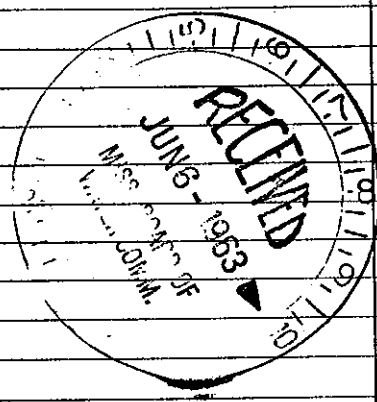

(Use Back Side)

Well No.

Mail this copy to Board of Water Commissioners 429 Miss. St. Jackson, Miss