

JONES

MISSISSIPPI BOARD OF WATER COMMISSIONERS

WATER WELL DRILLERS LOG

7-19-62

Date: 7/19, 1962, Driller: C.P. Clark County: Jones

(Name)

(1) Owner of Land:	Description & Color of Materials Sand, Clay, Red Clay, Shell, etc.	Thick- ness Feet	Depth Feet
(Name) W. P. Juchstene	0-60 Clay	60	
(Address) Rt #1 Laurel Miss	60-80 Sand	20	
(2) Location: 1/4, 1/4, Sec. 2 T. 7 R. 11 W.	80-100 Sandy Clay	30	
8 miles S.E. of Laurel	100-115 Sand	15	
(3) Topography: (Hilly) (Flat) (Level)	115-140 Clay	35	
(4) Purpose of Well: (Domestic, Irrigation, Municipal, Industrial, Other)	140-198 Gray Sand	58	
	198-220 Clay	22	
	220-230 Sand	10	
	230-307 Gray Clay	77	
	307-368 Sand	61	


Information upon completion of well:

- (1) Diameter 2 inches.
- (2) Total Depth 368 feet.
- (3) Water Level 65 feet below top of ground.
- (4) Cased to 352, Size 2
- (5) Screen: Size 1 1/4, Length 16
- (6) Were any formations sealed against pollution?  
yes,  no.

If YES depth of formation

Why

Drillers Remarks:

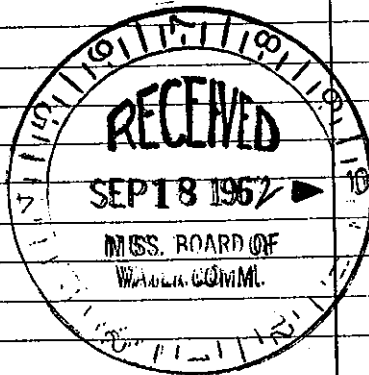

(Use Back Side)

Well No.

Mail this copy to Board of Water Commissioners 429 Miss. St. Jackson, Miss