

C. P. CLARK
WATER WELL DRILLING
 ROUTE 2

MISSISSIPPI LAUREL, MISS. 39440
BOARD OF WATER COMMISSIONERS
 416 North State Street
 Jackson, Mississippi 39201

WATER WELL DRILLERS LOG

JONES
 L 17
 12-67

12/6 1967 *C. P. Clark* Jones
 date well completed firm name county well located

LANDOWNER: *Good Hope Baptist Church*
Rt #1 outlet Miss
 (mailing address)


description of formations encountered	from	to
<i>Hard Clay</i>	<i>0</i>	<i>80</i>
<i>Sandy Clay</i>	<i>80</i>	<i>95</i>
<i>Hard Clay</i>	<i>95</i>	<i>290</i>
<i>fine sand</i>	<i>290</i>	<i>335</i>
<i>Medium sand</i>	<i>335</i>	<i>352</i>

WELL LOCATION:
 sec. *13* T. *7* N. R. *11* E
9 miles *S.E.* of *Laurel*
 (distance) (direction) (nearest town)

WELL PURPOSE: *Church*
 (home, irrigation, municipal, industrial)

- WELL COMPLETION DATA:
- (1) diameter (inches) *2*
 - (2) total depth (feet) *352*
 - (3) static water level (feet) *72* below above top of ground.
 - (4) casing *2 in Galv*, *332*
 (material) (depth)
 _____ if telescope see back.
 (size)
 - (5) screen *20*, *332*
 (length) (depth to top)
1/4", *Brass*
 (size) (material)
 - (6) pump *1*, *10*
 (HP) (yield gpm)
220V Single Phase
 (type power)
 - (7) electric log *No*
 (yes or no)

 (organization running log)
 - (8) how well bottom plugged _____

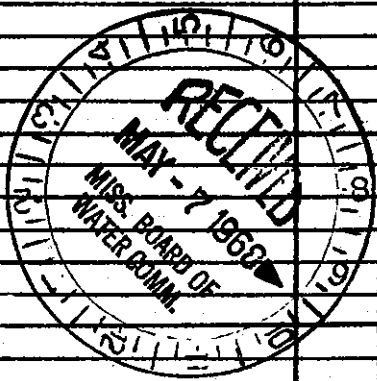

DRILLERS REMARKS: _____