

JONES MISSISSIPPI BOARD OF WATER COMMISSIONERS

WATER WELL DRILLERS LOG

⑥ L/18
7-20-64
Date: 7/20, 1964, Driller: C.P. Clark County: Jones

(Name)

		Description & Color of Materials Sand, Clay, Red Clay, Shell, etc.	Thick- ness Feet	Depth Feet
(1) Owner of Land: W.B. Glauer (Name)		0-50 Clay	50	
Rt # 3 Ellisville Miss (Address)		50-90 Sandy Clay	40	
(2) Location: 1/4, 1/4, Sec. 9 T7R1W		90-200 Clay	110	
5 miles S.E. of Ellisville (distance) (direction) (Nearest Town)		200-285 Sandy Clay	85	
(3) Topography: Hilly (Hilly) (Flat) (Level)		285-310 Sand	25	
(4) Purpose of Well: Domestic (Domestic Irrigation Municipal, Industrial, Other)				


Information upon completion of well:

- (1) Diameter 2 inches.
- (2) Total Depth 310 feet.
- (3) Water Level 45 feet below top of ground.
- (4) Cased to 294, Size 2 in
- (5) Screen: Size 1 1/4, Length 16
- (6) Were any formations sealed against pollution?
yes, no.

If YES depth of formation 195

Why Seal Surface

Drillers Remarks:

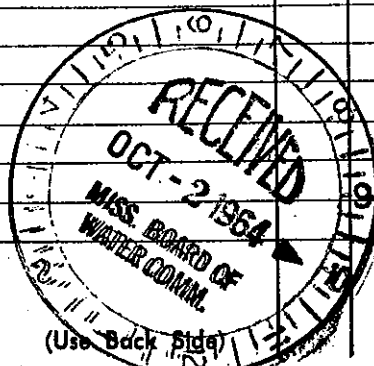

Well No.

Mail this copy to Board of Water Commissioners 429 Miss. St. Jackson, Miss.