

Jones
L 21
7-66

MISSISSIPPI BOARD OF WATER COMMISSIONERS

WATER WELL DRILLERS LOG

Date: 7/14, 1966, Driller: C. J. Clark County, Jones
(Name)

(1) Owner of Land:	Description & Color of Materials	Thick-ness Feet	Depth Feet
<u>Duston Tanner</u> (Name) <u>RT #1 Ellisville Miss</u> (Address)	<u>0-80 Clay</u>	<u>80</u>	
	<u>80-90 fine Sand</u>	<u>10</u>	
(2) Location: <u>NW 1/4, SE 1/4, Sec. 6 T4R4</u> <u>3 miles East of Ellisville</u> (distance) (direction) (Nearest Town)	<u>90-130 Clay</u>	<u>40</u>	
	<u>130-140 Sandy Clay</u>	<u>10</u>	
	<u>140-183 Mined</u>	<u>43</u>	
(3) Topography: <u>Hilly</u> (Hilly) (Flat) (Level)	<u>183-195 fine Sand</u>	<u>12</u>	
(4) Purpose of Well: <u>Domestic Irrigation</u> (Domestic Irrigation Municipal, Industrial, Other)	<u>195-277 Clay</u>	<u>82</u>	
	<u>277-327 Sand</u>	<u>50</u>	

Information upon completion of well:

(1) Diameter: ~~30~~ inches.

(2) Total Depth: 327 feet.

(3) Water Level: 85 feet below top of ground.

(4) Cased to 301, Size 2


(5) Screen: Size 1 1/4, Length 20

(6) Were any formations sealed against pollution?
_____ yes, _____ no. yes

If YES depth of formation _____

Why _____

Drillers Remarks: _____

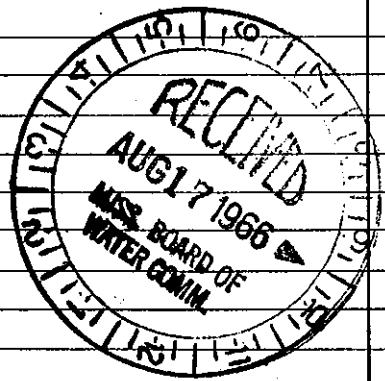

Well No.

(Use Back Side)