

Jones
 L 28
 8-68

MISSISSIPPI
 BOARD OF WATER COMMISSIONERS
 416 North State Street
 Jackson, Mississippi 39201

CODED

WATER WELL DRILLERS LOG


8-2 1968 *Hershel Taylor Water Well Drilling* *Jones*
 date well completed firm name county well located

LANDOWNER	description of formations encountered	from	to
<i>pt. 1</i>	<i>blue chalk</i>	<i>0</i>	<i>100</i>
<i>Dwell, Miss</i>	<i>rock</i>	<i>100</i>	<i>112</i>
(mailing address)	<i>blue shell chalk</i>	<i>112</i>	<i>240</i>
	<i>fine sand</i>	<i>240</i>	<i>252</i>

WELL LOCATION:
 sec. 4 T. 7 N. R. 11 E.
5 miles East of Edwards
 (distance) (direction) (nearest town)

WELL PURPOSE:
 (home, irrigation, municipal, industrial)

- WELL COMPLETION DATA:
- (1) diameter (inches) 2"
 - (2) total depth (feet) 252
 - (3) static water level (feet) 60' below top of ground.
 - (4) casing galv. 248
 (material) (depth)
2" If telescope see back.
 (size)
 - (5) screen 6' 246
 (length) (depth to top)
2" 5/8
 (size) (material)
 - (6) pump 1 6000
 (HP) (yield/gpm)
electric
 (type power)
 - (7) electric log (yes or no) _____
 (organization running log) _____
 - (8) how well bottom plugged back w/plate

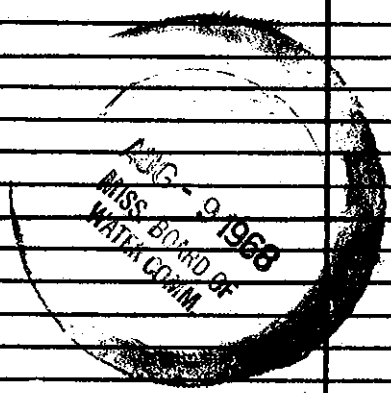

DRILLERS REMARKS: