

**C. P. CLARK  
WATER WELL DRILLING  
ROUTE 2**

MISSISSIPPI LAUREL, MISS. 39440  
BOARD OF WATER COMMISSIONERS  
416 North State Street  
Jackson, Mississippi 39201

CODED

**WATER WELL DRILLERS LOG**

*Jones*  
*L 29*  
*7-68*

*7/10* 19 *68* *C. P. Clark* *Jones*  
date well completed firm name county well located


LANDOWNER: *Theadon Jells*  
*Rt # 1*  
*Mull Miss*  
(mailing address)

| description of formations encountered | from       | to         |
|---------------------------------------|------------|------------|
| <i>Clay</i>                           | <i>0</i>   | <i>16</i>  |
| <i>Sand</i>                           | <i>16</i>  | <i>38</i>  |
| <i>Clay</i>                           | <i>38</i>  | <i>225</i> |
| <i>Sand</i>                           | <i>225</i> | <i>237</i> |

WELL LOCATION:  
sec. *13* T. *7* N. R. *11* E  
*8* miles *South* of *Laurel*  
(distance) (direction) (nearest town)

WELL PURPOSE: *Home*  
(home, irrigation, municipal, industrial)

- WELL COMPLETION DATA:
- (1) diameter (inches) *2*
  - (2) total depth (feet) *237*
  - (3) static water level (feet) *35* below above top of ground.
  - (4) casing *Galv Steel* *225*  
(material) (depth)  
*2* if telescope see back.  
(size)
  - (5) screen *12* *225*  
(length) (depth to top)  
*1/4* *Bronze*  
(size) (material)
  - (6) pump *1* *15*  
(HP) (yield gpm)  
*220V Single P.*  
(type power)
  - (7) electric log *NO*  
(yes or no)
  - (organization running log) *B.W.U*
  - (8) how well bottom plugged

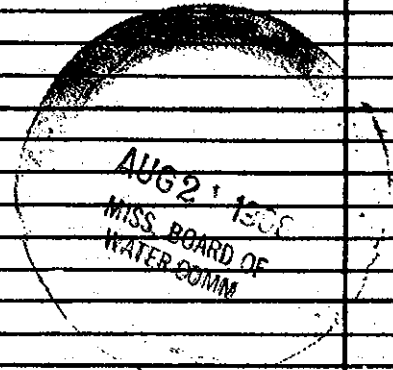

DRILLERS REMARKS: