

Jones
L 35
2-6-63

MISSISSIPPI BOARD OF WATER COMMISSIONERS

Case # 7/1/69
JW

WATER WELL DRILLERS LOG

Date: 2/6, 1963, Driller: C.P. Clark County: Jones
(Name)

COPIED

(1) Owner of Land:	Description & Color of Material	Thick-ness Feet	Depth Feet
<u>Carol Martin</u> (Name) <u>Saural Miss</u> (Address)	<u>0-20 Clay</u>	<u>20</u>	
(2) Location: <u>7 N/W</u> <u>3</u> miles <u>East</u> of <u>Osceola</u> (distance) (direction) (Nearest Town)	<u>20-64 Clay + Sand + gravel</u>	<u>44</u>	
(3) Topography: <input checked="" type="checkbox"/> (Hilly) <input type="checkbox"/> (Flat) <input type="checkbox"/> (Level)	<u>64-125 Sand</u>	<u>81</u>	
(4) Purpose of Well: <u>Domestic</u> (Domestic Irrigation, Municipal, Industrial, Other)			

Information upon completion of well:


- (1) Diameter 2 inches.
- (2) Total Depth 135 feet.
- (3) Water Level 68 feet below top of ground.
- (4) Cased to 119, Size 2 in
- (5) Screen: Size 1/4, Length 6 ft
- (6) Were any formations sealed against pollution?
_____ yes, no.

If YES depth of formation _____

Why _____

Drillers Remarks: _____

COPIED

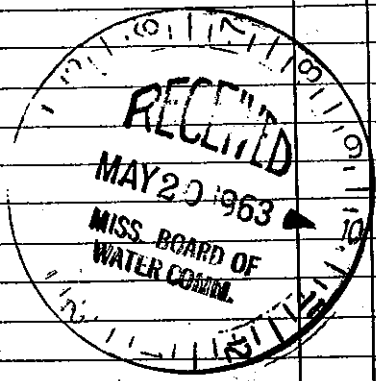

(Use Back Side)

Well No.

Mail this copy to Board of Water Commissioners 429 Miss. St. Jackson, Miss