

JONES MISSISSIPPI BOARD OF WATER COMMISSIONERS

U.S. Forest Service


WATER WELL DRILLERS LOG

6-18-64

Date: 6/18, 1964, Driller: C.P. Clark County Jones

(Name)

	Description & Color of Materials Sand, Clay, Red Clay, Shell, etc.	Thick- ness Feet	Depth Feet
(1) Owner of Land: <u>U.S. Forest Service</u>			
(Name) <u>Jackson Miss</u>	<u>0-20 Tan Clay</u>	<u>20</u>	
(Address) <u>SE 1/4, NW 1/4, Sec. 6, T. 2 N, R. 10 W</u>	<u>20-30 Yellow Clay</u>	<u>10</u>	
(2) Location: <u>SE 1/4, NW 1/4, Sec. 6, T. 2 N, R. 10 W</u>	<u>30-45 Grey Sandy Clay</u>	<u>15</u>	
<u>12</u> miles <u>S.E.</u> of <u>Jarvis</u>	<u>45-87 Grey Clay</u>	<u>42</u>	
(distance) (direction) (Nearest Town)	<u>87-111 Course Sand</u>	<u>24</u>	
(3) Topography: <input checked="" type="checkbox"/> (Hilly) <input type="checkbox"/> (Flat) <input type="checkbox"/> (Level)			
(4) Purpose of Well: <u>Recreation Area</u>			
(Domestic, Irrigation, Municipal, Industrial, Other)			
<u>at Point Jarvis</u>			
<u>Recreation Area</u>			
Information upon completion of well:			
(1) Diameter <u>2</u> inches.			
(2) Total Depth <u>111</u> feet.			
(3) Water Level _____ feet below top of ground.			
(4) Cased to <u>101</u> , Size <u>2 in</u>			
(5) Screen: Size <u>10 ft</u> , Length <u>1 3/4</u>			
(6) Were any formations sealed against pollution?			
<input checked="" type="checkbox"/> yes, _____ no.			
If YES depth of formation <u>84</u>			
Why <u>Seal Surface Water</u>			
Drillers Remarks:			

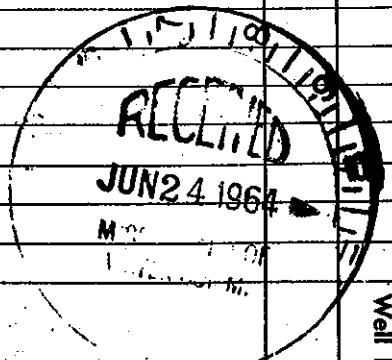

(Use Back Side)

Well No.

Mail this copy to Board of Water Commissioners 429 Miss. St. Jackson, Miss.