

③ JONES
M 11/4

WATER WELL DRILLERS LOG

65 C. S. Clark & Son Laurel Jones

Date: _____, 19____, Driller _____ County _____

(Name)
O. B. Forest Service

(1) Owner of Land: Jackson, Miss
(Address)

(2) Location: NE 1/4, Sec 6, T10N, R10E
9 miles (distance) of (direction) (Nearest Town)

(3) Topography: (Hilly) (Flat) (Level)

(4) Purpose of Well: (Domestic) (Municipal) (Industrial) (Other)


Description	Color of Material	Thickness Feet	Depth Feet
0	Sandy Clay	15	
15-42	Grey Clay	27	
42-60	Sandy Clay	18	
60-70	fine sand	10	
70-90	Sandy Clay	20	
90-140	Clay	50	
140-305	dry sand	165	
305-395	Clay	90	
395-460	Sand	65	
460-570	Clay	110	
570-640	hard sand	70	
640-689	Clay	49	
689-691	Rock	02	
691-693	Sandy	02	
693-695	Rock	02	
695-703	Clay	08	

Information upon completion of well:

- (1) Diameter: 6 1/4 ins.
- (2) Total Depth: 100 feet.
- (3) Water Level: 610 feet below top of ground. 4m
- (4) Cased to: 3 3/4, Size 30
- (5) Screen: Size _____, Length _____

(6) Were any formations sealed against pollution?
yes, 5.16 ft and 27.2 ft
If YES depth of formation _____
Why: Water cut

Driller's Remarks: off

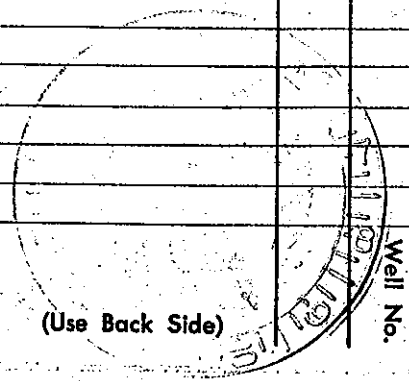

Retain this copy for your office files.

(Use Back Side)